

JACKSON Co.  
 0433  
 1-19-84

Elog# 259

MISSISSIPPI DEPARTMENT OF NATURAL RESOURCES  
 Bureau of Land and Water Resources  
 Southport Mall  
 P.O. Box 10631  
 Jackson, Mississippi 39209  
**WATER WELL DRILLERS LOG**

**COPIED**

Jan. 19. 19 84 GRINER DRILLING SER. JACKSON  
 date well completed firm name county well located

LANDOWNER: CITY OF  
MOSS POINT,  
TEST HOLE No. 1  
 (mailing address)

description of formations encountered	from	to
	<u>TOP SOIL</u>	<u>0</u>
<u>CLAY</u>	<u>3</u>	<u>90</u>
<u>SAND</u>	<u>90</u>	<u>185</u>
<u>CLAY</u>	<u>185</u>	<u>212</u>
<u>SAND</u>	<u>212</u>	<u>220</u>
<u>CLAY</u>	<u>220</u>	<u>234</u>
<u>SAND</u>	<u>234</u>	<u>264</u>
<u>CLAY w/ thin SAND STRATA</u>	<u>264</u>	<u>512</u>

WELL LOCATION: N 1/4 NE 1/4 NW 1/4  
 sec. 19 T. 7 N. R. 5 E.  
 (S) (W)  
 (distance) miles (direction) of (nearest town)

WELL PURPOSE:  
 (home, irrigation, municipal, industrial)

WELL COMPLETION DATA:

(1) diameter (inches) \_\_\_\_\_

(2) total depth (feet) \_\_\_\_\_

(3) static water level (feet) \_\_\_\_\_ below above top of ground.

(4) casing (material) \_\_\_\_\_ (depth) \_\_\_\_\_  
 (also) If telescope see back.

(5) screen (length) \_\_\_\_\_ (depth to top) \_\_\_\_\_  
 (size) \_\_\_\_\_ (material) \_\_\_\_\_

(6) pump (HP) \_\_\_\_\_ (yield gpm) \_\_\_\_\_  
 (type power) \_\_\_\_\_

(7) electric log (yes or no) \_\_\_\_\_  
 (organization running log) \_\_\_\_\_

(8) how well bottom plugged \_\_\_\_\_

*TEST HOLE*

**COPIED**

DEPT. OF NATURAL RESOURCES  
 BUREAU OF LAND & WATER RESOURCES


APR 30 1984

**RECEIVED**

DRILLERS REMARKS: \_\_\_\_\_

If well telescopes please sketch and show depths.

GROUND LEVEL

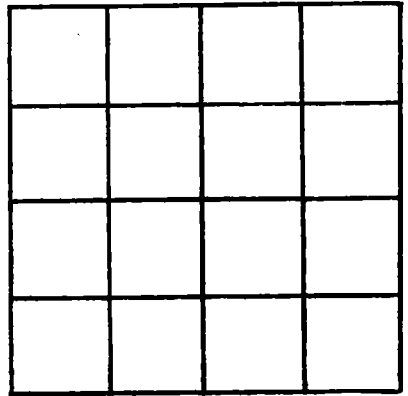

SECTION \_\_\_\_\_

Please indicate well location X.

ADDITIONAL INFORMATION

If more than one screen,  
show locations of each on sketch.