

JACKSON  
 434  
 10/84

MISSISSIPPI DEPARTMENT OF NATURAL RESOURCES  
 Bureau of Land and Water Resources  
 Southport Mall  
 P.O. Box 10631  
 Jackson, Mississippi 39209  
 WATER WELL DRILLERS LOG

MS-GW-01416

CODED

19 84 GRINER DRILLING SERVICE JACKSON  
 date well completed firm name county well located

LANDOWNER: CITY OF  
MOSS POINT, I 10 +  
6.3 WELL  
 (mailing address)

description of formations encountered	from	to
	<u>TOP SOIL</u>	<u>0</u>
<u>CLAY</u>	<u>3</u>	<u>15</u>
<u>SAND</u>	<u>65</u>	<u>30</u>
<u>SANDY CLAY</u>	<u>30</u>	<u>55</u>
<u>SAND + THIN</u>	<u>55</u>	<u>190</u>
<u>CLAY + SAND STRAINS</u>	<u>190</u>	<u>398</u>
<u>SAND MEDIUM</u>	<u>398</u>	<u>436</u>
<u>CLAY</u>	<u>436</u>	<u>507</u>

WELL LOCATION: NW 1/4 Behind Area  
sec. 18 T 7 N R 5 E  
 (distance) miles (direction) of (nearest town)

WELL PURPOSE:  
 (home, irrigation, municipal, industrial)


- WELL COMPLETION DATA:
- (1) diameter (inches) 10 3/4
  - (2) total depth (feet) 436 ft.
  - (3) static water level (feet) 49 below top of ground.
  - (4) casing steel 392 Contd (material) (depth) Inside
  - 10 3/4 (size) if telescope see back.
  - (5) screen 35 ft. 400 (length) (depth to top)  
6 5/8 304 5 in. (size) (material)
  - (6) pump 40 300 (HP) (yield gpm)  
Elect. (type power)
  - (7) electric log Yes (yes or no)  
MAGS (organization running log)
  - (8) how well bottom plugged 5 ft.  
Stinger + Black Wash/Vinyl

DRILLERS REMARKS:

RECEIVED

If well telescopes please  
sketch and show depths.

GROUND LEVEL

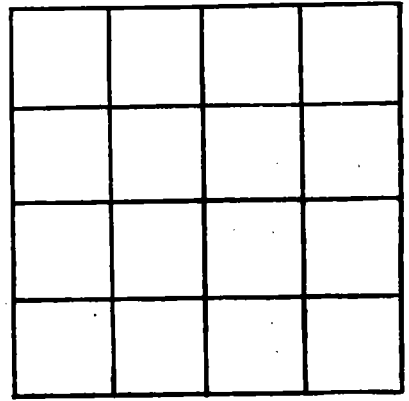

SECTION \_\_\_\_\_

Please indicate well location X.

ADDITIONAL INFORMATION

---

---

If more than one screen,  
show locations of each on sketch.