

MISSISSIPPI DEPARTMENT OF NATURAL RESOURCES

Bureau of Land and Water Resources

Southport Mall

P.O. Box 10631

Jackson, Mississippi 39209

WATER WELL DRILLERS LOG

Jackson  
Q 444

7-21-1984 date well completed  
S4 Cross Water Well Sew. firm name  
Jackson county well located

LANDOWNER: H. L. Stark  
7901 Bayou Cumberland  
Pascagoula Miss.  
(mailing address) 39167

description of formations encountered	from	to
Top soil (sandy)	0	8'
Blue Clay	8'	30'
Coarse sand	30'	55'
Blue Clay	55'	105'
Coarse sand	105'	143'
Blue Clay	143'	225'
Med. Sand	225'	270'

WELL LOCATION:  
sec 27 T 7 N R 5 E  
1 miles EAST of KREOLA  
(distance) (direction) (nearest town)

WELL PURPOSE: home  
(home, irrigation, municipal, industrial)

WELL COMPLETION DATA:

(1) diameter (inches) 2"

(2) total depth (feet) 270'

(3) static water level (feet) 50' below top of ground.

(4) casing PVC, 260'  
(material) (depth)  
2" if telescope see back.  
(size)

(5) screen 10', 260  
(length) (depth to top)  
2" PVC  
(size) (material)

(6) pump 1 h.p., 9  
(HP) (yield gpm)  
elect.  
(type power)

(7) electric log No.  
(yes or no)  
(organization running log)

10'-2" Tail Pipe

(8) how well bottom plugged  
back wash valve


DEPT. OF NATURAL RESOURCES  
BUREAU OF LAND & WATER RESOURCES

OCT 11 1984  
RECEIVED

DRILLERS REMARKS:

If well telescopes please sketch and show depths.

GROUND LEVEL

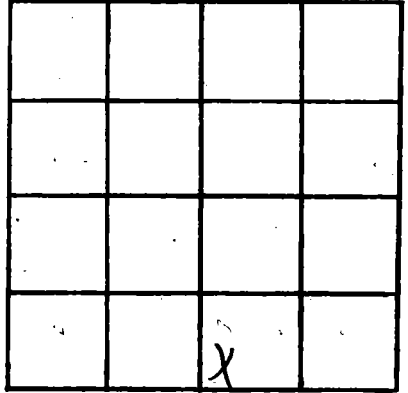

SECTION 27

Please indicate well location X.

ADDITIONAL INFORMATION

If more than one screen, show locations of each on sketch.