

MISSISSIPPI DEPARTMENT OF NATURAL RESOURCES

Bureau of Land and Water Resources

Southport Mall

P.O. Box 10631

Jackson, Mississippi 39209

WATER WELL DRILLERS LOG

Q
Q445

12-10-81 date well completed
 19 *Coast Water Well Sew.* firm name
Jackson county well located

LANDOWNER: *Jackson County New York*
P.O. Box 373
Pascagoula, Miss.
 (mailing address) *39567*

description of formations encountered	from	to
<i>Top soil</i>	<i>0</i>	<i>2'</i>
<i>Red med. sand</i>	<i>2</i>	<i>21'</i>
<i>Blue Clay & clamshell</i>	<i>21'</i>	<i>118'</i>
<i>gray coarse sand & gravel</i>	<i>118'</i>	<i>177'</i>
<i>Blue clay</i>	<i>177'</i>	<i>237'</i>
<i>gray coarse sand</i>	<i>237'</i>	<i>258'</i>

WELL LOCATION:
 sec. *4* T. *8* N. R. *5* E
1 N miles (distance) (direction) of *PASCAGOULA* (nearest town)

WELL PURPOSE:
 (home, irrigation, municipal, industrial)

- WELL COMPLETION DATA:
- (1) diameter (inches) *2"*
 - (2) total depth (feet) *258'*
 - (3) static water level (feet) *83'* below above top of ground.
 - (4) casing *PVC*, *248'*
 (material) (depth)
 - 2"* (size) if telescope see back.
 - (5) screen *10'*, *248'*
 (length) (depth to top)
 - 2"* (size), *PVC* (material)
 - (6) pump *2 H.P.*, *8*
 (HP) (yield gpm)
 - Elect.* (type power)
 - (7) electric log *No.*
 (yes or no)
 - (organization running log)
 - (8) how well bottom plugged *Backwash Valve*

DRILLERS REMARKS:


DEPT. OF NATURAL RESOURCES
 BUREAU OF LAND & WATER RESOURCES

JAN 26 1982

RECEIVED

If well telescopes please sketch and show depths.

GROUND LEVEL

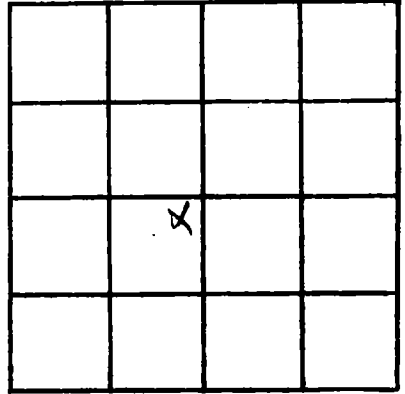

SECTION 4

Please indicate well location X.

ADDITIONAL INFORMATION

If more than one screen,
show locations of each on sketch.