

MISSISSIPPI DEPARTMENT OF NATURAL RESOURCES

Bureau of Land and Water Resources

Southport Mall

P.O. Box 10631

Jackson, Mississippi 39209

WATER WELL DRILLERS LOG

JACKSON
Q450

CODED

7-3-78

date well completed

19

Southern Well Drilling
firm name

county well located

LANDOWNER: *Mr. Hagen*
22nd St
Passagoula, MS
(mailing address)

description of formations encountered	from	to
<i>April</i>	<i>0</i>	<i>20</i>
<i>sandy clay</i>	<i>20</i>	<i>45</i>
<i>clay</i>	<i>45</i>	<i>50</i>
<i>sand</i>	<i>50</i>	<i>65</i>

WELL LOCATION:
sec. *18* T. *7* N. R. *5* E
(S) *(W)*
miles of (distance) (direction) (nearest town)

WELL PURPOSE: *irrigation*
(home, irrigation, municipal, industrial)

WELL COMPLETION DATA:

(1) diameter (inches) *2"*

(2) total depth (feet) *65*

(3) static water level (feet) *80* *below* above top of ground.

(4) casing *PVC* *60*
(material) (depth)
2"
(size) if telescope see back.

(5) screen *5* *60*
(length) (depth to top)
2" *PVC*
(size) (material)

(6) pump *1* *12*
(HP) (yield gpm)
all
(type power)

(7) electric log *N/A*
(yes or no)
(organization running log)

(8) how well bottom plugged *BWV*

RECEIVED


AUG 01 1988

Department of Natural Resources
Bureau of Land & Water Resources

DRILLERS REMARKS:

**If well telescopes please
sketch and show depths.**

GROUND LEVEL

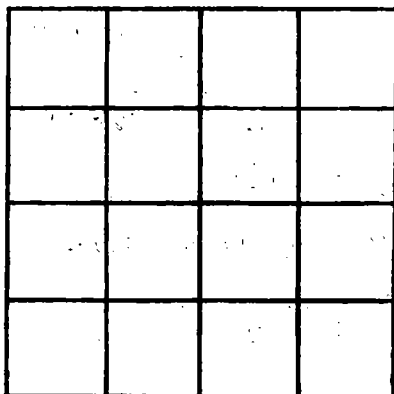

SECTION _____

Please indicate well location X.

ADDITIONAL INFORMATION

**If more than one screen,
show locations of each on sketch.**