

MISSISSIPPI DEPARTMENT OF NATURAL RESOURCES

Bureau of Land and Water Resources

COUNTY WELL LOCATED
Jackson
 WELL NUMBER **Q A1** ✓ CODED
Q462
 DATE WELL COMPLETED
1-15-90

PERMIT NUMBER
 NAME OF DRILLING FIRM
Coast water well Service

U. G. R. M. P.
 P.O. Box 10631
 itabelle Jackson, Mississippi 39209
WATER WELL DRILLERS LOG

NAME & MAILING ADDRESS OF LANDOWNER
Mike Porter
Pecan Rd,
Pascagoula Ms. 39564
 WELL LOCATION: SEC **7** TOWNSHIP **7** RANGE **4** W
 DISTANCE **5** Miles **E** of **Moss Point**
 OTHER LANDMARK
 WELL PURPOSE: Home, Irrigation, Municipal, Industrial, Fish Pond, etc.
home

PUMP DATA

PUMP TYPE (Circle One):
 Submersible, Turbine, **Jet** Flowing Well,
 Other (Describe) _____
 POWER TYPE (Circle One):
Electric, Tractor, Diesel, Gasoline, Butane,
 Other (Describe) _____ H/P _____
 Pump Capacity (GPM) **15** No. of Stages **1** Setting Depth _____ FT.
 PUMP TEST
 Well yielded _____ GPM with
 a drawdown of _____ ft.
 after _____ hours of pumping

WELL DATA

Well Depth 78'	Casing Diameter (In.) 2"	Casing Length (Ft.) 68'
Type of Casing PVC	Hole Depth 78'	Depth to Static Water Level 6'

TYPE OF COMPLETION: (Circle One or More):
 Gravel Packed, Underreamed, Telescoped,
Natural Development, Open Hole, Other
 (Describe) _____
 Top of Lap Pipe or Reduction in Casing
 FEET IF TELESCOPED OR MORE THAN ONE SCREEN: USE BACK PAGE

LOG DATA

TYPE OF LOG RUN (Circle One): **No Log Run**,
 Electric, Gamma Ray, Density, Sonic, Neutron,
 Other (Describe) _____
 Name of Organization Running Log

SCREEN DATA

Diameter - Inches 2"	Length - Feet 10'	Slot Size - Inches .008
Screen Type PVC	Depth to Bottom - Feet 78'	

GEOLOGIC DATA (Office Use Only)

Surface Elev.	Geologic Unit	Unit Thickness	Depth to Top
Subs. SWL	Drill	Analysis	Acquifer Test


RECEIVED
MAR 30 1990
 Department of Natural Resources
 Bureau of Land & Water Resources

DESCRIPTION OF FORMATIONS ENCOUNTERED	FROM TO		FORMATIONS (Continued)	FROM TO	
	FROM	TO		FROM	TO
Top Soil	0	1			
Red Fine Sand	1	5			
White Coarse Sand	5	13			
Brown Coarse Sand	13	25			
Blue Clay	25	48			
Blue Clay w/shell + streaks of sand	48	60			
Grey Coarse Sand	60	78			

IF MORE SPACE IS NEEDED, USE BACK

If well telescopes please sketch and show depths.

GROUND LEVEL

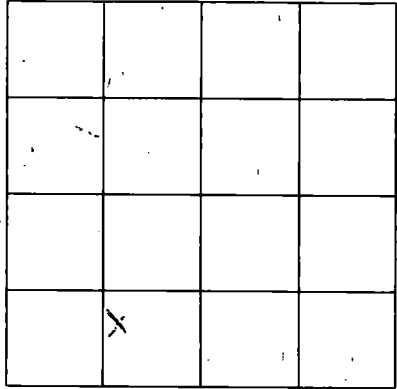

SECTION 2

Please indicate well location X.

ADDITIONAL INFORMATION

If more than one screen,
show location of each on sketch.