

**MISSISSIPPI DEPARTMENT OF NATURAL RESOURCES**  
Bureau of Land and Water Resources

COUNTY WELL LOCATED  
*Jackson*

WELL NUMBER  
*Q A 2*

CODE  
*✓*

DATE WELL COMPLETED  
*3-22-88*

PERMIT NUMBER

NAME OF DRILLING FIRM  
*Coast Water Well Sew.*

U. S. G. M. F.  
P.O. Box 10631  
Jackson, Mississippi 39209  
**WATER WELL DRILLERS LOG**

NAME & MAILING ADDRESS OF LANDOWNER  
*Glenn Hamilton*  
*Independence Rd*  
*Pascagoula Ms*

WELL LOCATION: SEC *5* TOWNSHIP *7 N* RANGE *4 E* *(W)*

DISTANCE *3* Miles DIRECTION *NE* of NEAREST TOWN *PECAN*

OTHER LANDMARK

WELL PURPOSE: Home, Irrigation, Municipal, Industrial, Fish Pond, etc.  
*home*

**PUMP DATA**

PUMP TYPE (Circle One):  
Submersible, Turbine, Jet Flowing Well, Other (Describe) \_\_\_\_\_

POWER TYPE (Circle One):  
Electric, Tractor, Diesel, Gasoline, Butane, Other (Describe) \_\_\_\_\_

Pump Capacity (GPM) *8* No. of Stages *1* Setting Depth \_\_\_\_\_ FT.

PUMP TEST  
Well yielded \_\_\_\_\_ GPM with a drawdown of \_\_\_\_\_ ft. after \_\_\_\_\_ hours of pumping

**WELL DATA**

Well Depth <i>150'</i>	Casing Diameter (In.) <i>2"</i>	Casing Length (Ft.) <i>135'</i>
Type of Casing <i>PVC</i>	Hole Depth <i>150'</i>	Depth to Static Water Level <i>6'</i>

TYPE OF COMPLETION: (Circle One or More):  
Natural Development, Gravel Packed, Underreamed, Telescoped, Open Hole, Other

Top of Lap Pipe or Reduction in Casing  
FEET IF TELESKOPED OR MORE THAN ONE SCREEN: USE BACK PAGE

**LOG DATA**

TYPE OF LOG RUN (Circle One):  
Electric, Gamma Ray, Density, Sonic, No Log Run, Neutron, Other (Describe) \_\_\_\_\_

Name of Organization Running Log

**SCREEN DATA**

Diameter - Inches <i>2"</i>	Length - Feet <i>10'</i>	Slot Size - Inches <i>.008</i>
Screen Type <i>PVC</i>	Depth to Bottom - Feet <i>145'</i>	

**GEOLOGIC DATA (Office Use Only)**

Surface Elev.	Geologic Unit	Unit Thickness	Depth to Top
Subs. SWL	Date	Analysis	Aquifer Test

Driller's Remarks

DESCRIPTION OF FORMATIONS ENCOUNTERED	FROM	TO
<i>Top Soil</i>	<i>0</i>	<i>2</i>
<i>White Coarse Sand</i>	<i>2</i>	<i>55</i>
<i>Blue Clay</i>	<i>55</i>	<i>127</i>
<i>Gray Coarse Sand</i>	<i>127</i>	<i>148</i>
<i>Blue Clay</i>	<i>148</i>	<i>150</i>

**RECEIVED**

**MAY 24 1988**


Department of Natural Resources  
Bureau of Land & Water Resources

FORWARDED TO (Company)	FROM	TO

IF MORE SPACE IS NEEDED, USE BACK

If well telescopes please sketch and show depths.

GROUND LEVEL

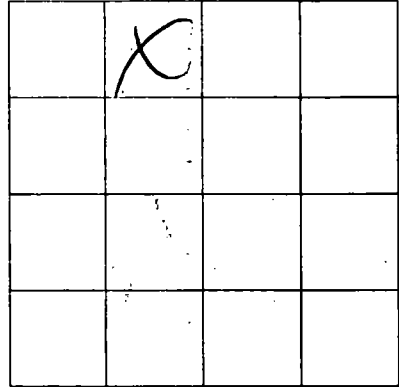

SECTION 5

Please indicate well location X.

ADDITIONAL INFORMATION

Lined area for additional information.

If more than one screen, show location of each on sketch.