	State Well Re	port	
Tackson	Part 1	-	For Office Use Only:
County: UACKSON	Mississippi Department of Envir	ronmental Ouality	Aquifer:
Permit #:	Office of Land and Water	r Resources	Well #: 369
Driller: COast Water Well SRV	P.O. Box 1063		Well #:
-	Jackson, MS 39289	-0631	L. S. Elevation:
Date drilling completed: 10-21-05	(601)961-5210)	
	(601)354-6938 (f	fax)	E-log #:
State Law requires that this rep	ort be prepared by the driller in	n detail and filed w	ith the Department within
30 days of completion of drilling of the well. Well Owner Information		Wel	Location
Owner Name Todd Reacock		20.25.100	" Longitude: 088. 28 . 34
Owner Name IUGA FEALUR	Latitude		_" Longitude: ds <u></u>
Mailing Address: COASTER RS			.2C ne): Conventional Survey,
	US	SGS quad, Hand-held	GPS, Survey-grade GPS Twn_T75 Rng R54
<u>moss Point</u> Ms. 39562 City State Zip Code		4 500 1/4 Sec 22	<u></u>
City Sta			
Telephone No. 228 217 - 8/3	U Distance	e Direction Miles	Nearest Town of <u>Moss Point</u>
	+		UI THOUSE FUTHIN
	Well Data		
Dumore of Wall (similar and Hanna to	ustrial Dublis Complex Tonis C	Eich Culture	Other
Purpose of Well (circle one) Home Ind			-
Date well drilling started:	-05 Date well drillin	ig completed:	-21-05
If flowing, method of flow regulation: Va	lve <u>MA</u> Other (describe)		
Static Water Level:feet at	ove or kelow circle one) land surfac	ce Date measured:	10-21-05
Method of Measurement (circle one) st	eel tape electric tape air li	ine other:	
Hole depth: Well dep	oth: 2 [1] ' Well gr	routed to a depth of	10feet
Type of grout (circle one): Cement			
Casing length: <u>200</u> feet Casir	ng diameter:inches	Type of casing:	PVC
Screen length: <u>10</u> feet Scre	en diameter: 2 inches	Type of screen:	PVC
Screen slot size:QOQinches	Setting depth: From <u>200</u>	feet to	feet
Type of completion (circle all applicable):	Gravel packed Underreamed	Telescoped Open	hole Natural Development
	Other (describe):		
Top of lap pipe or reduction in casing:	A11		een, describe on back of page
Logs run (circle all applicable): No log run	Electric Gamma Ray Density	Sonic Neutron	Other:
Name of organization running log(s):	JA		
I certify that the well was drilled, constr	ucted, and completed in accordance	e with all applicable	requirements of the Missission
Department of Environmental Anality	na or the prississiphi nebartment	vi ricalin regulations	AUG STATE IAWS.
Department of Environmental Quality a			
Department of Environmental Quality a	11-2	()	Al In
Department of Environmental Quality a Jack Ridgdell 0-	472	Jack	Refuer
Department of Environmental Quality a <u>Jack Kidgdell</u> 0- Print Name of Water Well Contractor and	472 License No.		

BY: OLWR


Q 569

If well telescopes please sketch below and show depths.

Grou

nd Level		Description of Formations Encountered	r rom	10
		TopSoil	0	3
	7	My COarse Sand WISTREAKS OF SHAN	2	TOS
	(q		<u> </u>	103
	Wł	itte Coarse Sand	105	123
	5	ILC Clay W/Streaks OF SAND	123	195
	p b	Income for clerke of onter	195	77
	[4]	Ay Coarse Sand	175	ary
	1.			
			_	
				I
				1
	·			
		······································		
		······································		
1	<u> </u>			

If more than one screen, show location of each on sketch

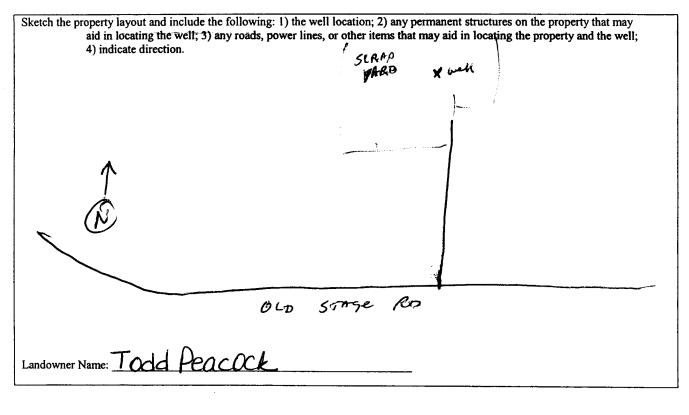

Signature of Water Well Contractor

NOV 17 2005 **BY: OLWR**

RECEIVED

STATE WELL REPORT				
County: <u>Jackson</u> Permit #: Driller: <u>Coust Water Well</u> Driller: <u>10, 20, 580</u> Pump Installer: Mississippi Departmen Office of Land P.O. I Jackson, M (601)	art 2 For Office Use Only: s Completion Report Aquifer: and Water Resources Aquifer: Box 10631 Well #: 567 465938 (fax) Elevation: Elevation:			
This report should be prepared by the pump installer in deta	il and filed with the Department within 30 days of the			
installation of pump. Well Owner Information	Well Location			
Owner Name: Todd Peacock	Latitude: 30.25.175 Longitude: 088, 28 340"			
Mailing Address: Coaster Rd.	Method of Lat/Long (circle one): Conventional Survey,			
	USGS quad, Hand-held GPS, Survey-grade GPS			
Moss Point MS 39562 City State Zip Code	5E 1/ SW 1/ Sec 22 Twn T75 Rng R5W			
City State Zip Code	Distance Direction Nearest Town			
Telephone No. (228) 217-8134	Y2_Miles East of MOSS Point			
Ритр Туре	Power Type			
Circle one	Circle one			
Air Lift Jet Submersible	Diesel Engine Gasoline Engine Natural Gas			
Bucket Piston Turbine	Electric Motor Hand Tractor PTO			
Centrifugal Rotary Flowing Well	Windmill Other (specify):			
Other (specify):	Horse Power Rating of Motor:			
Date Pump Installed: 10-22-05	Setting Depth: <u>40Ff. drop pipe</u> feet			
Rated Pump Capacity:Gallons Per Minute	Number of Stages:			
Pump Test Data	Method of Measuring Water Level Circle one			
Date Well Tested:				
Static Water Level (A):Feet Below Land Surface				
Pumping Water Level (B):Feet Below Land Surface	Other (specify):			
Drawdown [(B) – (A)]:Feet Below Land Surface	For flowing well, measured shut in head:feet			
Test Pumping Rate:Gallons Per Minute	Well yielded GPM with a drawdown of			
Duration of Pump Test (minimum 4 hours):4hours	N/Afeet afterN/Ahours of pumping			
I HEREBY CERTIFY that the above statements are true to the best of my knowledge Jack Ridgell 0-472 Jack Ridgell 0-472 Jack Ridgell Print Name of Pump Installer and License No. (if applicable) Signature of Pump Installer				
Print Name of Pump Installer and License No. (if applicable)	Signature of Pump Installer			
	RECEIVED			
	NOV 17 2005			
	BY: OLWR			

•

•