State W	/ell Report				
I TACKSON I	Part 1	For Office Use Only:			
Mississippi Departmen	t of Environmental Quality	Aquifer:			
	and Water Resources Box 10631	Well #: Q-672			
Driller UPST WALTON WEIISKU Jackson, M	AS 39289-0631	L. S. Elevation:			
Dute drining completion -	961-5210 4-6938 (fax)	E-log #:			
State Law requires that this report be prepared by the 30 days of completion of drilling of the well.	e driller in detail and filed w	vith the Department within			
Well Owner Information	Wel	l Location			
Owner Name Ricky Green	Latitude: <u>30 • 28 '244</u>	<u>)</u> " Longitude: 088. 30, 296"			
Mailing Address: 8901011jevice Rd	Method of Lat/Long (circle or				
	USGS quad, Hand-held	GPS Survey-grade GPS			
Mass Point MS 39562 City State Zip Code	Moss Point MS 39562 NW 1/2 NET/4 Sec 5				
Telephone No. 238 217-0899	Distance Direction	of Point			
Well	 Data				
\sim		Other			
Purpose of Well (circle one) (Home) Industrial Public Supply Irrigation Fish Culture Other:					
Date well drilling started: <u>3-31-06</u> Date	well drilling completed:	21-06			
If flowing, method of flow regulation: Valve N/A- Other (lescribe)				
Static Water Level:	land surface Date measured:	2-21-06			
Method of Measurement (circle one) steel tape electric tape	air line other:				
Hole depth:	Well grouted to a depth of	feet			
Type of grout (circle one): Cement Gentonite Mix					
Casing length: <u>220</u> feet Casing diameter: <u>2</u> inches Type of casing: <u>PVC</u>					
Screen length: 0 feet Screen diameter: 2 inches Type of screen: PVC					
Screen slot size:OOS_inches Setting depth: FromGOfeet toGOfeet					
Type of completion (circle all applicable): Gravel packed Underreamed Telescoped Open hole Natural Development					
Other (describe):					
Top of lap pipe or reduction in casing: <u>NA</u> feet. If the	elescoped or more than one scr	een, describe on back of page			
Logs run (circle all applicable): No log run Electric Gamma Ray	Density Sonic Neutron	Other:			
Name of organization running log(s): N/A- I certify that the well was drilled, constructed, and completed in	accordance with all applicable	requirements of the Mississippi			
Department of Environmental Quality and/or the Mississippi De					
Jack Ridodoll 0,1177		Alun			
Print Name of Water Well Contractor and License No.		Water Well Contractor			
L		RECEIVED			
		MAR 2 0 2006			

, **`**.

BY: OLWR

Q-512


If well telescopes please sketch below and show depths.

Ground Level

•

Description of Formations Encountered	From	To
 TopSoil	$+ \chi$	1A
Blue Clair White Marse Sand	- 99	55
BlueClay	55	145
Gray Coarse, Sand	- 145	23 C
		Ļ.
		+
······································		<u>+</u>
		ļ
		
		+
		<u> </u>
		+
		+
		1
		+
		J

If more than one screen, show location of each on sketch

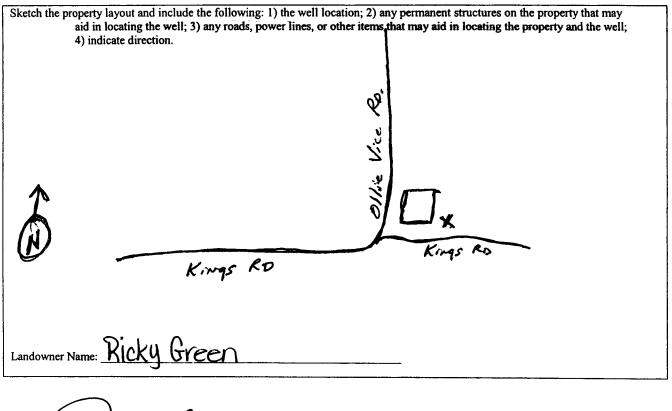

hbu Signature of Water Well Contractor

RECEIVED

MAR 2 0 2006 BY: OLWR

STATE WELL REPORT					
County: Jackson Permit #: Driller: Coast Water Wellsrv Date completed: 2-21-06	Part 2 Pump Installer's Completion Report Mississippi Department of Environmental Quality Office of Land and Water Resources P.O. Box 10631 Jackson, MS 39289-0631 (601)961-5210 (601)354-6938 (fax)		Aquifer: Well #:	ice Use Only: - 572	
This report should be prepared by the installation of pump.	e pump installer in dets	il and filed with the Departm	ent within 30 day	ys of the	
Well Owner Information	on	1	ll Location		
Owner Name: RickyGreen	Latitude: 30.48 C		40 ⁴ Longitude: <u>088°30' 296</u> " 13		
Mailing Address: 8901 Ollie Vice	<u><i>C</i></u> <u>Kd</u> . Method of Lat/Long (circle of		one): Conventional Survey,		
		USGS quad, Han	d-held GPS Surv	ey-grade GPS	
Moss Point-M	Mass Adint-Ms 39562 NW 1/ NE 1/2 Sec_		5_Twn 775 Rng R5W		
	- r	Distance Direction	Nearest Toy		
Telephone No. 208)217-0899		<u> </u>	of Moss F	246	
		P	ower Type		
Pump Type Circle one			Circle one		
Air Lift Jet	Submersible	Diesel Engine Gasoli	ine Engine	Natural Gas	
Bucket Piston	Turbine	Electric Motor Hand		Tractor PTO	
Centrifugal Rotary	Flowing Well	Windmill Other	(specify):		
Other (specify):		Horse Power Rating of Moto	т. <u>I HP</u>		
Date Pump Installed: <u>2-22-Cle</u> Setting Depth: <u>40FT. Droppipe</u> feet			_feet		
Rated Pump Capacity:9	Gallons Per Minute	Number of Stages:	2	_	
Pump Test Data	· · · · ·		easuring Water	Level	
Date Well Tested: <u>2-22-06</u>			Circle one		
15	Below Land Surface		asuring Line	Steel Tape	
Pumping Water Level (B): N/A Feet E	Below Land Surface	Other (specify):			
Drawdown [(B) - (A)]: NA Feet]	Below Land Surface	For flowing well, measured	shut in head:	NA feet	
Test Pumping Rate: 9	Gallons Per Minute	Well yielded 7	GPM with a c	irawdown of	
Duration of Pump Test (minimum 4 hours):	hours	N/A feet after	<u>N/A</u> h	ours of pumping	
I HEREBY CERTIFY that the above statem	ents are true to the best	of my knowledge	2/1/11		
Print Name of Pump Installer and License N	(if applicable)	Signature of Pump	Installer		
FINE MAINE OF FULLY HISTARIEL AND LICENSE IN		gignature of 1 unip		HEUEIVED	
		-		MAR 2 0 2006	
				BY: OLWR	

۰ ۱

,