State V	Vall Depart			
State Well Report		For Office Use Only:		
	Dunty: Jackson Part 1 Mississippi Department of Environmental Quality			
Permit #: Office of Land	Office of Land and Water Resources			
	Box 10631	well #: Q 588		
Jackson,	MS 39289-0631 1)961-5210	L. S. Elevation:		
(601)3	54-6938 (fax)	E-log #:		
State Law requires that this report be prepared by the driller in detail and filed with the Department within				
30 days of completion of drilling of the well. Well Owner Information	Wel	Location		
Owner Name Thomas Jackson		_" Longitude: 08 24 '279"		
Mailing Address: 3700 Finland Ave				
	USGS quad, Hand-held	GPS, Survey-grade GPS		
MOSS POINT, MS 39502 SW 1/ NE 1/ Sec 33		GPS, Survey-grade GPS Twn $775$ Rng $R5 \omega$		
Telephone No. 228) 475 - 8198	Distance Direction	Nearest Town of <u>MCSS POINT</u>		
Well	Data			
Purpose of Well (circle one) Home Industrial Public Supply Irrigation Fish Culture Other:				
Date well drilling started: $10 - 18 - 07$ Date well drilling completed: $10 - 18 - 07$				
If flowing, method of flow regulation: Valve NA Other	describe)			
Static Water Level: 50feet above or below (circle one) land surface Date measured: 10-18-07				
Method of Measurement (circle one) steel tape electric tape air line other:				
Hole depth: <u>343</u> Well depth: <u>343</u> Well grouted to a depth of <u>10</u> feet				
Type of grout (circle one): Cement Bentonite Mix				
Casing length: <u>228</u> feet Casing diameter: <u>2</u> inches Type of casing: <u>DVC</u>				
Screen length: <u>15</u> feet Screen diameter: <u>2</u> inches Type of screen: <u>DVC</u>				
Screen slot size:inches Setting depth: From	<u>228</u> feet to <u>6</u>	2 <u>43</u> feet		
Type of completion (circle all applicable): Gravel packed Underreamed Telescoped Open hole Natural Development				
Other (describe):				
Top of lap pipe or reduction in casing:feet. If telescoped or more than one screen, describe on back of page				
Logs run (circle all applicable). No log run Electric Gamma Ray Density Sonic Neutron Other:				
Name of organization running log(s): N/A				
I certify that the well was drilled, constructed, and completed in accordance with all applicable requirements of the Mississippi				
Department of Environmental Quality and/or the Mississippi Department of Health regulations and state laws.				
Talter Bidadkins 0-9712 / / Khilar				
Print Name of Water Well Contractor and License No.	Signature of V	Water Well Contractor		
		NOV () E 2007		
		BY: OLWR		

•

•


1588

If well telescopes please sketch below and show depths.

. 1

Ground Level	Description of Formations Encountered	From To
	TOD SOIL	02
	Gray coarse sand	338
	Brown Coarse sand	38 82
	Blueclay	83 114
	White course scund	114 108
	Blue clay	108173
	Gray Coarse sand	173 193
	Blueclay	192019
	Gray Course sand	019243
	·····	_ <u>_</u>

If more than one screen, show location of each on sketch

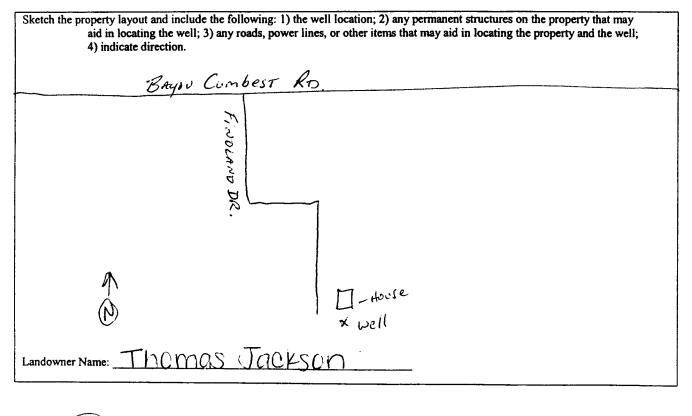

Signature of Water Well Contractor

NOV 6 5 2607 BY: OLVV F

STATE WELL REPORT					
County: <u>JCICKSON</u> Permit #:	Pump Installer's Mississippi Departmer	Part 2 Pump Installer's Completion Report Mississippi Department of Environmental Quality			
Permit #: Driller(OCIST Water W	LISA P.O. I Jackson, N	Box 10631 AS 39289-0631	well #: <u>Q 588</u>		
Date completed: $10 - 18 - 0$	(001)	(601)961-5210 (601)354-6938 (fax)			
This report should be prepared by the pump installer in detail and filed with the Department within 30 days of the					
installation of pump. Well Owner	- Information	tion Well			
Owner Name: Thom	as Jackson	Tackson Latitude: 30°23'U13"			
Mailing Address: 3700 F	inland Ave				
USGS quad,		USGS quad, Hand-	held GPS, Survey-grade GPS		
OceanSp	Ocean Springs, MS 371542 SW 1/ NE 1/2 Sec_3		3 Twn 775 Rng R5W		
City	State Zip Code	Distance Direction	Nearest Town		
Telephone No. (238 475	338 475-8198 1/2 Miles SE of		Moss Point		
		I			
	p Type le one		ver Type rcle one		
Air Lift Jet	Submersible	Diesel Engine Gasoline	e Engine Natural Gas		
Bucket Piston	Turbine (	Electric Motor Hand	Tractor PTO		
Centrifugal Rotary	Flowing Well	Windmill Other (s	specify):		
Other (specify):		Horse Power Rating of Motor:			
Date Pump Installed: 10 - 23 - 07		Setting Depth: 80 Ft. CIOP Pipe feet			
Rated Pump Capacity:	Rated Pump Capacity:				
·					
•	Test Data 3-177		suring Water Level rcle one		
Date Well Tested: 10-33-07 Air Line Electric Measuring Line Steel Tape					
Static Water Level (A):Feet Below Land Surface Other (specify):		Other (specify):	a		
Pumping Water Level (B): $N   A$ Feet Below Land Surface Drawdown [(B) – (A)]: $N   A$ Feet Below Land Surface For flowing well, measured shut in head: $N   A$ feet					
		For flowing well, measured shut in head: $1014$ feet Well yielded $25$ GPM with a drawdown of			
Duration of Pump Test (minimum 4 hours): 4 hours		NIA_feet afterhours of pumping			
I HEREBY CERTIFY that the above statements are true to the best of my knowledge.					
The Flying A-JUM () will a					
Print Name of Pump Installer and License No. (if applicable) Signature of Pump Installer					
			NOV D 5 2002		

•

•

٠

.

.

BY: OLW/F