

County: Jackson
 Permit #: _____
 Driller: Walker-Hill Environmental, Inc.
 Date drilling completed: 4/1/08

State Well Report
Part 1 – Driller's Log

Mississippi Department of Environmental Quality
 Office of Land and Water Resources
 P.O. Box 10631
 Jackson, MS 39289-0631
 (601)961-5210
 (601)354-6938 (fax)

For Office Use Only:
 Aquifer: _____
 Well #: Q 590
 L. S. Elevation: _____
 E-log #: _____

State Law requires that this report be prepared by the license holder responsible for the work and filed with the Department at the above address within 30 days of completion of drilling of the well or borehole.

| Information on Well Owner (Landowner if borehole is not for a water well) | Well or Borehole Location |
|--------------------------------------------------------------------------------------------------------------------------------------------------------------------------------------------|-------------------------------------------------------------------------------------------------------------------------------------------------------------------------------------------------------------------------------------------------------------------------------------------------------------------------------------------------------------------------------------------------------------------------------------------------------------------------|
| Owner Name <u>Chevron Products Company</u> Mailing Address: <u>PO Box 1300</u> <u>Pascagoula</u> MS 39568 City State Zip Code Telephone No. (<u>228</u>) <u>938-4600</u> | Latitude: <u>30 ° 20 ' 51 "</u> Longitude: <u>88 ° 28 ' 18 "</u> Method of Lat/Long (circle one): Conventional Survey, <input checked="" type="radio"/> USGS quad, <input type="radio"/> Hand-held GPS, <input type="radio"/> Survey-grade GPS <u>SE</u> ¹⁵ / ₂₁ <u>NW</u> ¹⁵ / ₂₁ Sec <u>21</u> Twn <u>8S</u> Rng <u>5W</u> Distance Direction Nearest Town <u>4.5</u> Miles <u>SE</u> of <u>Pascagoula</u> |

Well / Borehole Data

Date drilling started: 3/31/08 Date drilling completed: 4/1/08 Hole depth: 54' Hole diameter: 8.25"

Location of the source of any surface water used for drilling: N/A
 Method of dosing and volume of Chlorine used in drilling and development: _____

Logs run (circle all applicable): No log run Electric Gamma Ray Density Sonic Neutron Other: _____
 Name of organization running log(s): _____

Purpose of borehole (check one): Water Well ___ Geotechnical/Geological Investigation ___ Ground Source Heat Pump ___
 Seismic Survey ___ Other (describe) Monitoring Well

If drilling is not related to water well construction, skip the remainder of this block

Purpose of Well (check one): Home ___ Industrial ___ Public Supply ___ Irrigation ___ Fish Culture ___ Other: monitor

If a flowing well, method of flow regulation: Valve _____ Other (describe) _____

Static Water Level: 10 feet above or below (circle one) land surface Date measured: 4/4/08

Method of Measurement (circle one) steel tape electric tape air line other: _____

Well depth: 52 Well grouted to a depth of 30 feet Type of grout (circle one) Neat Cement Bentonite Mix

Casing length: 37 feet Casing diameter: 2 inches Type of casing: PVC

Screen length: 15 feet Screen diameter: 2 inches Type of screen: PVC

Screen slot size: .010 inches Setting depth: From 37 feet to 52 feet

Type of completion (circle all applicable): Gravel packed ___ Underreamed ___ Telescoped ___ Open hole ___ Natural Development ___
 Other (describe): Stick up completion with 3'x3' concrete pad


Top of lap pipe or reduction in casing: _____ feet. ***If telescoped or more than one screen, describe on next page***

Form: OLWR-SWR-1A
RECEIVED
 MAY 23 2008
 BY: OLWR

The sketch below only required for water wells

Description of formations encountered must be provided for all wells and boreholes, unless specifically exempted by regulations

If well telescopes, show depths on sketch.

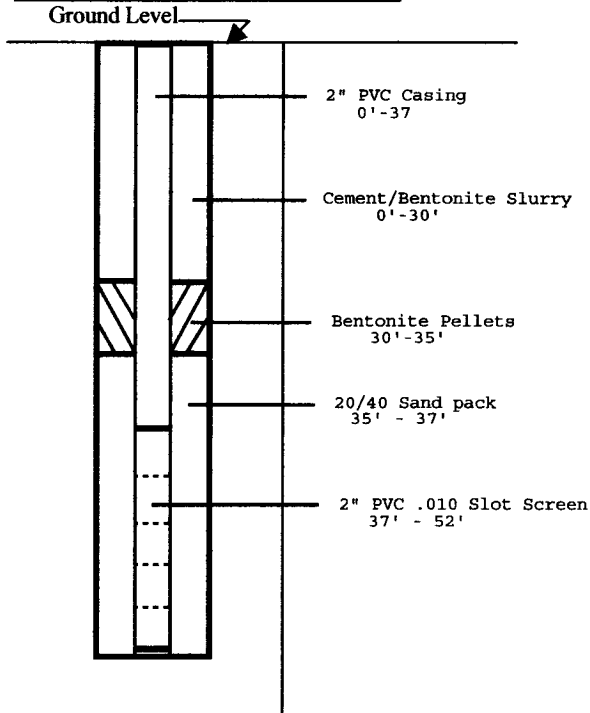

| Description of Formations Encountered | From (depth) | To (depth) |
|---------------------------------------|--------------|------------|
| Fill dirt | Ground Level | 10' |
| Silty clay | 10' | 13' |
| Silty sand | 13' | 15' |
| No recovery | 15' | 17.5' |
| Clayey sand | 17.5' | 19' |
| Fat Clay | 19' | 36' |
| Silty clay | 36' | 39' |
| Clayey sand | 39' | 43' |
| Clayey silt | 43' | 46' |
| Silty clay | 46' | 47' |
| Fat clay | 47' | 49' |
| Clayey sand | 49' | 51' |
| Silt | 51' | 52.5' |
| Fat clay | 52.5' | 54' |
| | | |
| | | |
If more than one screen, show location of each on sketch

Sketch the property layout and include the following: 1) the well location; 2) any permanent structures on the property that may aid in locating the well; 3) any roads, power lines, or other items that may aid in locating the property and the well; 4) a north arrow.

See Attached Map

Landowner Name: Chevron Products Co. - (MW10-3D)

Form: OLWR-SWR-1A

I certify that the well/borehole was drilled, constructed, and completed in accordance with all applicable requirements of the Mississippi Department of Environmental Quality and the Mississippi Department of Health regulations, if applicable, and state laws.

GARY P. Hill 0-578 5-19-08
 Print Name of Responsible Licensee and License No. Date

Gary P Hill
 Signature of Licensee

RECEIVED

MAY 23 2008
 BY: OLWR