	State W	ell Report	En-Office Use Only	
County: Jackson	P	art 1	For Office Use Only:	
	Mississippi Department of Environmental Quality		Aquifer:	
Permit #:	Office of Land and Water Resources P.O. Box 10631		Well #: <u>Q-599</u>	
Driller Crast Water WellsRV		IS 39289-0631	L. S. Elevation:	
Date drilling completed: 1-8-09	` '	961-5210 4 6039 (6)	E-log #:	
		4-6938 (fax)		
State Law requires that this report be prepared by the driller in detail and filed with the Department within 30 days of completion of drilling of the well.				
Well Owner Information			Location	
Owner Name U.O. Group		Latitude: 30 · 32 · 98	" Longitude: \( \oldsymbol{\infty} \cdot \frac{\infty}{37} \)	
Mailing Address: 6917 Stennis Blvd. Method o		Method of Lat/Long (circle or		
0			USGS quad, Hand-held GPS, Survey-grade GPS	
Yascagoula Ms 39581 City State Zip Code		NE 1/4 NW1/4 Sec 4 Twn T85 RngR5W		
Telephone No. (208) 475 - 3360		Distance Direction Nearest Town  1/2 Miles EAST of ASCAGESIA		
	Well I	Data		
Purpose of Well (circle one) Home Industrial Public Supply Irrigation Fish Culture Other:				
Date well drilling started: 1-09 Date well drilling completed: 1-8-09				
If flowing, method of flow regulation: Valve Other (describe)				
Static Water Level: 30 feet above or below (circle one) land surface Date measured: 1-8-09				
Method of Measurement (circle one) steel tape electric tape air line other:				
Hole depth: 170 FT Well depth: 170 FT Well grouted to a depth of 10 feet				
Type of grout (circle one): Cement Bentonite Mix				
Casing length: 150 feet Casing diameter: 4 inches Type of casing: PVC				
Screen length: QO feet Screen diameter: the inches Type of screen: PVC				
Screen slot size: inches Setting depth: From   50 feet to   100 feet				
Type of completion (circle all applicable): Gravel packed Underreamed Telescoped Open hole Natural Development				
Other (describe):				
Top of lap pipe or reduction in casing: NA feet. If telescoped or more than one screen, describe on back of page				
Logs run (circle all applicable): No log run Electric Gamma Ray Density Sonic Neutron Other:				
Name of organization running log(s):  Name of organization running log(s):				
Department of Environmental Quality and/or the Mississippi Department of Health regulations and state laws.				
Jack Ridgell 0-4-12 Jan Robbell				
J	· · · · · · · · · · · · · · · · · · ·			

Print Name of Water Well Contractor and License No.


RECEIVED

If well telescopes please sketch below and show depths.

Ground Level		

Description of Formations Encountered	From	То
TOPSOIL	0	3
orange + Blue Clay	3	SE
White Coarse Earnal	35	8
White Charse Sand	SA	HE
Bueclay	TIE	Tas
Gray coarse Sano	192	170
1		
	<del> </del>	
		لــــا

If more than one screen, show location of each on sketch

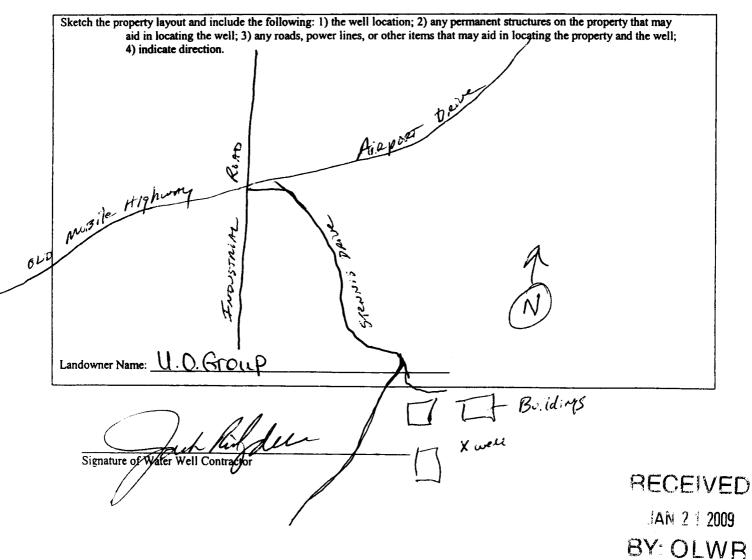

## STATE WELL REPORT

## County: Jackson Permit #: Driller Coast Water Wellsay.

## Part 2

Pump Installer's Completion Report
Mississippi Department of Environmental Quality
Office of Land and Water Resources
P.O. Box 10631
Jackson, MS 39289-0631

(601) 961-5210 (601) 354-6938 (fax)

For Office Use Only:		
Aquifer:		
Vell #: _	Q-599	
levation:	·	

This report should be prepared by the pump installer in detail and filed with the Department within 30 days of the installation of pump. Well Location Well Owner Information Latitude: 20° 22'981" Longitude: 088 29'609" 691-15/ennis Blud Method of Lat/Long (circle one): Conventional Survey, Mailing Address: USGS quad, (Hand-held GPS) Survey-grade GPS NE 1 NW 1 Sec 4 Twn T85 Rng R5W Pascagoula Ms 39581
City State Zip Code Distance Direction Nearest Town Telephone No. 228,475-3360 1/2 Miles FAST of PASCAGOSLA Power Type Pump Type Circle one Circle one Gasoline Engine Natural Gas Diesel Engine Submersible Air Lift Jet Electric Motor Hand Tractor PTO **Bucket** Piston **Turbine** Centrifugal Flowing Well Windmill Other (specify): Rotary Horse Power Rating of Motor: 3 Other (specify): Date Pump Installed: 1-8-07 Gallons Per Minute Rated Pump Capacity: Number of Stages: Method of Measuring Water Level Pump Test Data Circle one Date Well Tested: 1-8-09 Air Line Electric Measuring Line Steel Tape Static Water Level (A): 50 Feet Below Land Surface Other (specify): Pumping Water Level (B): NA Feet Below Land Surface Drawdown [(B) – (A)]: \_\_\_\_\_NA Feet Below Land Surface For flowing well, measured shut in head: NA feet Well yielded 106 GPM with a drawdown of Test Pumping Rate: Gallons Per Minute NA feet after NA hours of pumping Duration of Pump Test (minimum 4 hours):

I HEREBY CERTIFY that the above statements are true to the best Trick Ridgell 0-472	at of my knowledge.
Print Name of Pump Installer and License No. (if applicable)	Signature of Pump Installer
	SEOFIL

RECEIVED

BY: OLWR