

# State Well Report

## Part 1

Mississippi Department of Environmental Quality  
Office of Land and Water Resources  
P.O. Box 10631  
Jackson, MS 39289-0631  
(601) 961-5210  
(601) 354-6938 (fax)

### For Office Use Only:

Aquifer: Q 609  
Well #: \_\_\_\_\_  
L. S. Elevation: \_\_\_\_\_  
E-log #: \_\_\_\_\_

County: Jackson  
Permit #: \_\_\_\_\_  
Driller: Coast Water Wells Serv.  
Date drilling completed: 6-11-10

State Law requires that this report be prepared by the driller in detail and filed with the Department within 30 days of completion of drilling of the well.

Well Owner Information	Well Location
Owner Name: <u>David Pettis</u>	Latitude: <u>30° 24' 694"</u> Longitude: <u>088° 27' 240"</u>
Mailing Address: <u>4908 Orange Grove Rd.</u>	Method of Lat/Long (circle one): Conventional Survey, USGS quad, <u>Hand-held GPS</u> Survey-grade GPS
<u>Moss Point, MS 39562</u>	<u>NW</u> 1/4 <u>NE</u> 1/4 Sec <u>26</u> Twn <u>T7S</u> Rng <u>R5W</u>
City State Zip Code	Distance Direction Nearest Town
Telephone No. <u>228 475-3492</u>	<u>3</u> Miles <u>NE</u> of <u>PASCAGOULA</u>

### Well Data

Purpose of Well (circle one) Home Industrial Public Supply Irrigation Fish Culture Other: \_\_\_\_\_

Date well drilling started: 6-11-10 Date well drilling completed: 6-11-10

If flowing, method of flow regulation: Valve N/A Other (describe) \_\_\_\_\_

Static Water Level: 20 feet above or below (circle one) land surface Date measured: 6-11-10

Method of Measurement (circle one) steel tape electric tape air line other: \_\_\_\_\_

Hole depth: 240 FT. Well depth: 240 FT. Well grouted to a depth of 10 feet

Type of grout (circle one): Cement Bentonite Mix

Casing length: 230 feet Casing diameter: 2 inches Type of casing: PVC

Screen length: 10 feet Screen diameter: 2 inches Type of screen: PVC

Screen slot size: .004 inches Setting depth: From 230 feet to 240 feet

Type of completion (circle all applicable): Gravel packed Underreamed Telescoped Open hole Natural Development

Other (describe): \_\_\_\_\_

Top of lap pipe or reduction in casing: N/A feet. If telescoped or more than one screen, describe on back of page

Logs run (circle all applicable) No log run Electric Gamma Ray Density Sonic Neutron Other: \_\_\_\_\_

Name of organization running log(s): N/A

I certify that the well was drilled, constructed, and completed in accordance with all applicable requirements of the Mississippi Department of Environmental Quality and/or the Mississippi Department of Health regulations and state laws.

Jack Ridgell 0-472  
Print Name of Water Well Contractor and License No.


Jack Ridgell RECEIVED  
Signature of Water Well Contractor JUN 18 2010

BY: OLWR

If well telescopes please sketch below and show depths.

Q609


Ground Level

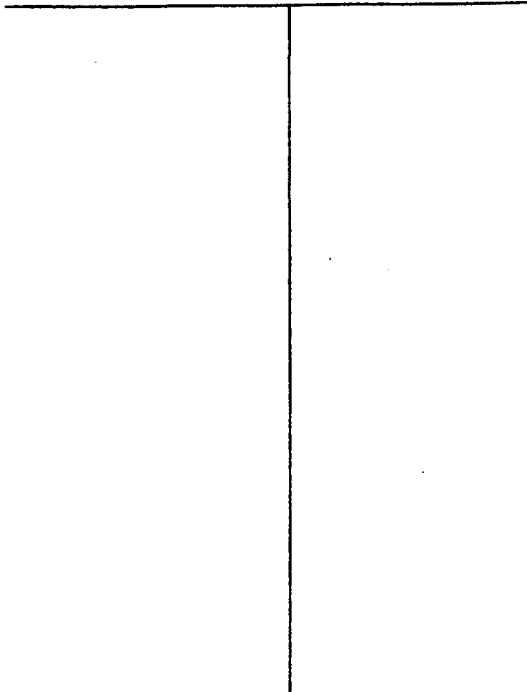

Description of Formations Encountered	From	To
Top Soil	0	2
Orange Clay	2	75
White coarse Sand	75	60
Blue Clay	60	63
White coarse Sand	63	148
Blue Clay	148	223
Gray medium Sand	223	240

If more than one screen, show location of each on sketch

Sketch the property layout and include the following: 1) the well location; 2) any permanent structures on the property that may aid in locating the well; 3) any roads, power lines, or other items that may aid in locating the property and the well; 4) indicate direction.

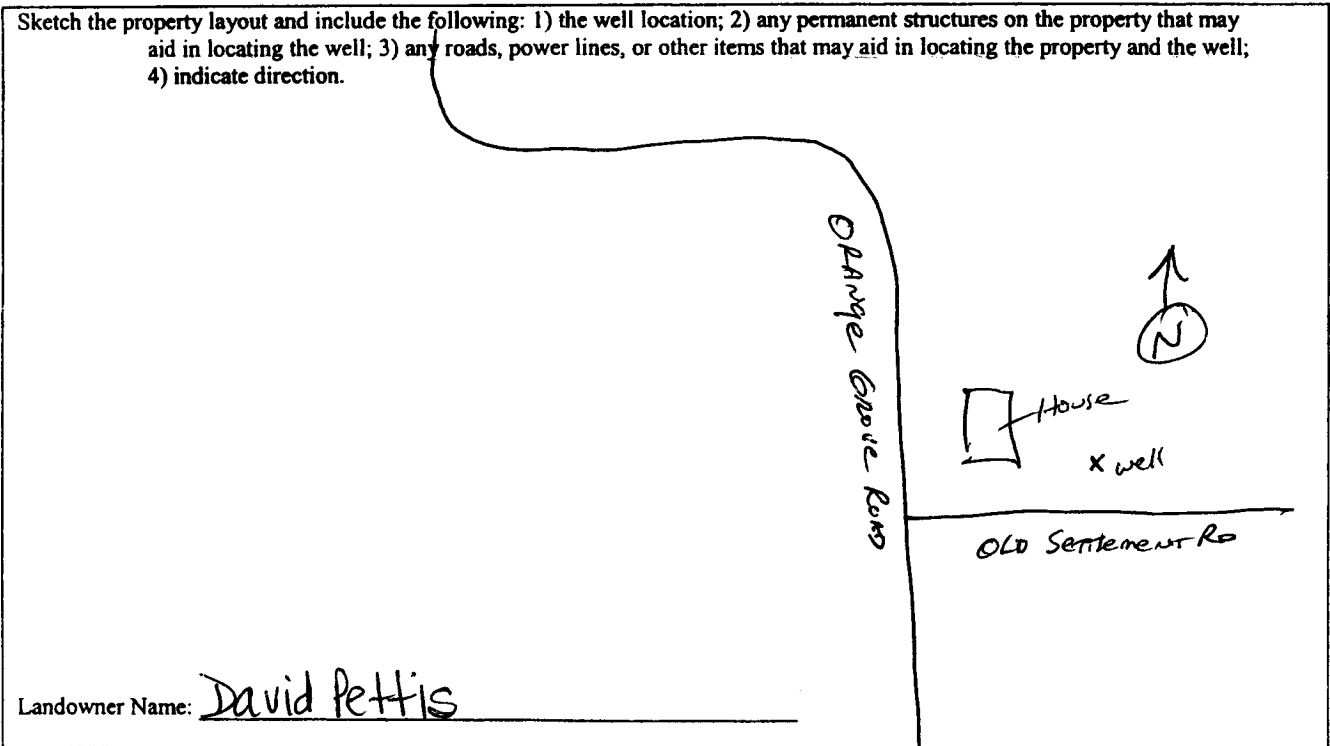

Landowner Name: David Pettis

John Reddick  
Signature of Water Well Contractor

RECEIVED  
JUN 18 2010  
BY: OLWR

# STATE WELL REPORT

Q609

## Part 2

**Pump Installer's Completion Report**  
 Mississippi Department of Environmental Quality  
 Office of Land and Water Resources  
 P.O. Box 10631  
 Jackson, MS 39289-0631  
 (601) 961-5210  
 (601) 354-6938 (fax)

For Office Use Only:

Aquifer: \_\_\_\_\_  
 Well #: \_\_\_\_\_  
 Elevation: \_\_\_\_\_

County: Jackson  
 Permit #: \_\_\_\_\_  
 Driller: Coast Water Well Serv.  
 Date completed: 6-11-10

**This report should be prepared by the pump installer in detail and filed with the Department within 30 days of the installation of pump.**

Well Owner Information	Well Location
Owner Name: <u>David Pe-His</u>	Latitude: <u>30° 24' 694"</u> Longitude: _____
Mailing Address: <u>4908 Orange Grove Rd.</u>	Method of Lat/Long (circle one): Conventional Survey,
<u>Missport, MS 39562</u>	USGS quad, <u>(Hand-held GPS)</u> Survey-grade GPS
City                      State                      Zip Code	<u>NW 1/4 NE 1/4 Sec 26 Twn 77S Rng R5W</u>
Telephone No. <u>208, 475-3492</u>	Distance                      Direction                      Nearest Town
	<u>3</u> Miles <u>NE</u> of <u>PASCAGOULA</u>

Pump Type Circle one	Power Type Circle one
Air Lift <input checked="" type="radio"/> Jet                      Submersible	Diesel Engine                      Gasoline Engine                      Natural Gas
Bucket <input type="radio"/> Piston                      Turbine	<input checked="" type="radio"/> Electric Motor                      Hand                      Tractor PTO
Centrifugal <input type="radio"/> Rotary                      Flowing Well	Windmill                      Other (specify): _____
Other (specify): _____	Horse Power Rating of Motor: <u>1 HP</u>
Date Pump Installed: <u>6-12-10</u>	Setting Depth: <u>40ft. Drop Pipe</u> feet
Rated Pump Capacity: <u>9.5</u> Gallons Per Minute	Number of Stages: <u>2</u>

Pump Test Data	Method of Measuring Water Level Circle one
Date Well Tested: <u>6-12-10</u>	<input checked="" type="radio"/> Air Line                      Electric Measuring Line                      Steel Tape
Static Water Level (A): <u>20</u> Feet Below Land Surface	Other (specify): _____
Pumping Water Level (B): <u>N/A</u> Feet Below Land Surface	For flowing well, measured shut in head: <u>N/A</u> feet
Drawdown [(B) - (A)]: <u>N/A</u> Feet Below Land Surface	Well yielded <u>26</u> GPM with a drawdown of
Test Pumping Rate: <u>9.5</u> Gallons Per Minute	<u>N/A</u> feet after <u>N/A</u> hours of pumping
Duration of Pump Test (minimum 4 hours): <u>4</u> hours	

I HEREBY CERTIFY that the above statements are true to the best of my knowledge.

Jack Ridgell 0-472  
 Print Name of Pump Installer and License No. (if applicable)

Signature of Pump Installer

**RECEIVED**  
 JUN 13 2010  
 BY: OLWR