

STATE WELL REPORT

Part 1

Driller's Log

Mississippi Department of Environmental Quality
Office of Land and Water Resources
P. O. Box 2309
Jackson, MS 39225-2309
(601)961-5210
(601)360-0535 (fax)

For Office Use Only:

Well #: Q625
Aquifer: _____
E-Log #: _____

County: Jackson
Permit #: _____
Driller: Coast Water Wells, Inc.
Date drilling completed: 6-11-14

State Law requires that this report be prepared by the license holder responsible for the work and filed with the Department at the above address within 30 days of completion of drilling of the well or borehole.

Well Owner Information (Landowner if borehole is not for a water well)	Well or Borehole Location
Owner Name: <u>David Alexander</u>	Latitude: <u>30° 28' 19.74"</u> Longitude: <u>088° 25' 41.70"</u>
Mailing Address: <u>10813 Iakso RD</u>	Method of Lat/Long (check one): Conventional Survey _____ USGS quad _____, Hand-held GPS <input checked="" type="checkbox"/> , Survey-grade GPS _____
<u>MOSS POINT, MS 39562</u>	<u>NW 1/4 RW 1/4, Sec 6 T 7 S R 4 W</u>
City State Zip Code	<u>6</u> Miles <u>NE</u> of <u>MOSS POINT, MS.</u>
Telephone No. <u>228 475-6599</u>	(Distance) (Direction) (Nearest Town)

Well / Borehole Data	
Date drilling started: <u>6-10-14</u> Date drilling completed: <u>6-11-14</u> Hole depth: <u>405 FT</u> Hole diameter: <u>2</u>	
Location of the source of any surface water used for drilling: <u>N/A</u>	
Method of dosing and volume of Chlorine used in drilling and development: <u>1 gal per 1000 Drilling 2 gal in Well</u>	
Logs run (circle all applicable): <input checked="" type="checkbox"/> No log run <input type="checkbox"/> Electric <input type="checkbox"/> Gamma Ray <input type="checkbox"/> Density <input type="checkbox"/> Sonic <input type="checkbox"/> Neutron Other: _____	
Name of organization running log(s): _____	
Purpose of borehole (circle one): <input checked="" type="checkbox"/> Water Well <input type="checkbox"/> Geotechnical/Geological Investigation <input type="checkbox"/> Ground Source Heat Pump <input type="checkbox"/> Seismic Survey Other (describe) _____	
<i>If drilling is not related to water well construction, skip the remainder of this block</i>	
Purpose of Well (circle all applicable): <input checked="" type="checkbox"/> Home <input type="checkbox"/> Industrial <input type="checkbox"/> Public Supply <input type="checkbox"/> Irrigation <input type="checkbox"/> Fish Culture	
Other (describe): _____	
If a flowing well, method of flow regulation: Valve <input checked="" type="checkbox"/> Other (describe) _____	
Static Water Level: <u>+3</u> feet <input checked="" type="checkbox"/> (above) <input type="checkbox"/> (below) land surface Date measured: <u>6-11-14</u>	
Method of measurement (circle one): Steel tape <input type="checkbox"/> Electric tape <input type="checkbox"/> <input checked="" type="checkbox"/> Air line Other (describe): _____	
Well depth: <u>405 FT</u> Well grouted to a depth of: <u>10</u> feet Type of grout (circle one): Neat Cement <input type="checkbox"/> <input checked="" type="checkbox"/> Bentonite Mix	
Casing length: <u>395</u> feet Casing diameter: <u>2</u> inches Type of casing: <u>PVC</u>	
Screen length: <u>10</u> feet Screen diameter: <u>2</u> inches Type of screen: <u>PVC</u>	
Screen slot size: <u>.006</u> inches Setting depth: From <u>395</u> feet to <u>405'</u> feet	
Type of completion (circle all applicable): Gravel packed <input type="checkbox"/> Underreamed <input type="checkbox"/> Open hole <input checked="" type="checkbox"/> Natural Development	
Other (describe): _____	
Top of lap pipe or reduction in casing: <u>N/A</u> feet	
<i>If telescoped or more than one screen, describe on next page</i>	

RECEIVED

Form: OLWR-SWR-1A (4/13)
JUN 30 2014


BY: OLWR

County: Jackson
 Permit #: _____

For Office Use Only:
 Well #: Q625

The sketch below only required for water wells
If well telescopes, show depths on sketch.


Description of formations encountered must be provided for all wells and boreholes, unless specifically exempted by regulations

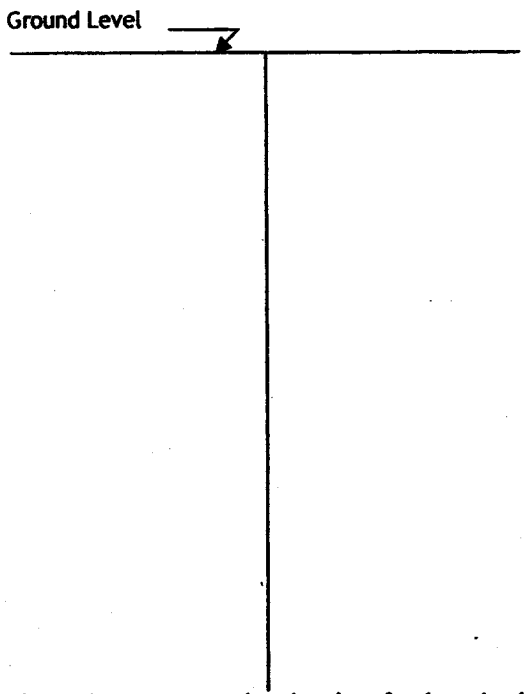

Description of Formations Encountered	From (depth)	To (depth)
TOP SOIL	Ground level	2
Orange Clay	2	20
Gray Clay	20	67
White coarse sand	67	80
Blue clay	80	146
Gray coarse sand	146	165
Blue Clay	165	199
Gray coarse sand	199	247
Blue clay	247	376
Gray coarse sand w/ gravel	376	405

If more than one screen, show location of each on sketch

- Sketch the property layout and include the following:
- 1) the well location
 - 2) any permanent structures on the property that may aid in locating the well
 - 3) any roads, power lines, or other items that may aid in locating the property and the well
 - 4) north arrow

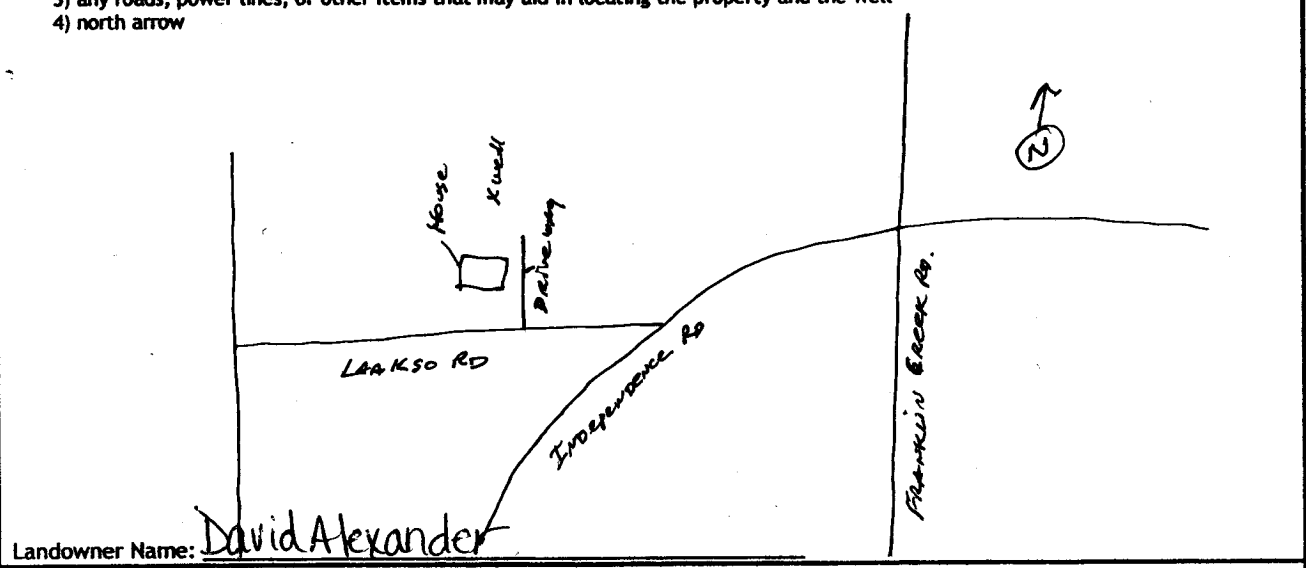

Landowner Name: David Alexander

I HEREBY CERTIFY that the well/borehole was drilled, constructed, and completed in accordance with all applicable requirements of the Mississippi Department of Environmental Quality and the Mississippi Department of Health regulations, if applicable, and state laws.

Jack Ridgell 0-472 6/12/14
 Print Name of Responsible Licensee and License No. Date

Jack Ridgell
 Signature of Licensee

RECEIVED
 Form: OLWR-SWR-1A (4/13)
 JUN 30 2014

BY: OLWR

STATE WELL REPORT

Part 2

Pump Installer's Completion Report

Mississippi Department of Environmental Quality

Office of Land and Water Resources

P.O. Box 2309

Jackson, MS 39225-2309

(601)961-5210

(601) 360-0535 (fax)

County: Jackson
Permit #: _____
Driller: Const Water Well Sku
Date completed: 6-11-14
Copy information from block on Part 1

For Office Use Only:
Well #: Q625
Aquifer: _____

This part of the report must be completed by a licensed water well contractor or a licensed pump installer. A copy of Part 1 of the report must be attached and both parts filed with the Department at the above address within 30 days of well completion.

Well Owner Information	Well Location
Owner Name: <u>David Alexander</u>	Latitude: <u>30° 28' 19.74"</u> Longitude: <u>088° 25' 41.70"</u>
Mailing Address: <u>10813 LAAKSORD</u>	Method of Lat/Long (check one): Conventional Survey _____, USGS quad _____, Hand-held GPS <input checked="" type="checkbox"/> , Survey-grade GPS _____
<u>MOSS POINT, MS 39562</u>	<u>NW 1/4 NW 1/4, Sec 6 T. 7 S R. 4 W</u>
City State Zip Code	<u>6</u> Miles <u>NE</u> of <u>MOSS POINT</u>
Telephone No. <u>601 475-6599</u>	(Distance) (Direction) (Nearest Town)

Pump Type (circle one)
Submersible Turbine Air Lift Centrifugal Flowing Well Jet Piston Rotary Other (describe): _____
Date Pump Installed: 6-11-14 Rated Pump Capacity: 15 Gallons Per Minute
Is This Pump (circle one): New Repaired Replacement Existing

Power Type (circle one)
 Electric Diesel Gasoline Natural Gas Tractor PTO Windmill Other (describe): _____
Horse Power Rating of Motor: 1 HP Setting Depth: 20 FT DP feet Number of Stages: 1

Pump Test Data for Non Flowing Well
Date Well Tested: 6-11-14 Duration of Pump Test (minimum 4 hours): 5 hours
Static Water Level (A): Flow + 3 Feet Below Land Surface Pumping Water Level (B): N/A Feet Below Land Surface
Drawdown [(B) - (A)]: N/A Feet Below Land Surface Test Pumping Rate: 15 Gallons Per Minute
Method of measurement (circle one): Steel tape Electric tape Air line Other (describe): _____

Pump Test Data for Flowing Well
Measured shut in head: 3 feet.
Well yielded 30 GPM with a drawdown of 0 feet after 4 hours of pumping

Meter Installation
Meter Manufacturer: _____ Meter Serial Number: _____
Meter Model Number/Name: N/A Type of Meter: _____
Totalizer Register Unit and Multiplier Factor (AF x .001, gal x 1000, etc): _____
Installation Date: _____ Meter installed by: _____
Is This Meter (circle one): New Repaired Replacement

Important: By submitting the above information you are certifying that this meter was installed to manufacturer standards. For agricultural wells, a list of approved meters is on the MDEQ website.

I HEREBY CERTIFY that the above statements are true to the best of my knowledge.
Jack Ridgell 0-472 6/11/14 [Signature]
Print Name of Pump Installer and License No. (if applicable) Date Signature of Pump Installer

Form: OLWR-SWR-1B (4/13)
JUN 30 2014

BY: OLWR