	STATE WELL REPORT						
F 1-	Part 1						
County: Tackson	Driller's Log	For Office Use Only:					
Permit #: 1136W-17326	Mississippi Department of Environmental Quality Office of Land and Water Resources	Well #: _ Gx ' C 36					
Driller: Lynan Well	P.O. Box 2309	Aquifer:					
	Jackson, MS 39225-2309	E-LOG #					
Date drilling completed: 9/19/1	(601)961-5555						
(601)961-5228 (fax) State Law requires that this report be prepared by the license holder responsible for the work and filed with the Department at the above address within 30 days of completion of drilling of the well or borehole.							
Well Owner Informati		Well or Borehole Location Latitude: 30'38.01 Longitude: 88' 30'19,35''					
(Landowner if borehole is not for							
Owner Name: Jackson Count	101 TAuthor B						
Mailing Address: 3033 Pasca	souk 5+ Method of Lat/Long (check one	Method of Lat/Long (check one): Conventional Survey,					
	USGS quad, Hand-held G	SPSL, Survey-grade GPS					
D I ME	JOTO TR 14 IR 4 Ser	17 T 85 R 5W					
<u>lascazoula M3</u> City State							
	Miles 0	of(Nearest Town)					
Telephone No. (228) 762-404	(Distance) (Direction)	(Nedrest Town)					
Well / Borehole Data							
Date drilling started $\frac{8/30/7}{7}$ Date drilling completed: $\frac{9/9/7}{7}$ Hole depth: 370 Hole diameter: $\frac{10XC}{7}$							
Location of the source of any surface w							
	he used in drilling and development: <u>bleach</u>						
	un Detectric Doamma Ray Density Sonic Neutr	on Other:					
Name of organization running log(s): _		1					
Purpose of borehole (check one): Water	Well Geotechnical/Geological Investigation	Ground Source Heat Pump					
Seism	ic Survey Other (<i>describe</i>)	······					
If drilling is not rela	ited to water well construction, skip the remainde	r of this block					
Purpose of Well (check all applicable):	Home Industrial Dublic Supply Irrigation	Fish Culture					
Other (describe):							
	ation: Valve Other (<i>describe</i>)						
Static Water Level:feetabove orbelow] land surface Date measured:/19/17							
	Steel tape Electric tape Air line Other (<i>describe</i>						
Well depth: <u>365</u> Well grouted to a depth of: <u>35</u> feet Type of grout (check one) Neat Cement Bentonite 2 Mix							
Casing length: <u>3-5</u> feet Casing diameter: <u>10</u> inches Type of casing: <u>5tee 1</u>							
Screen length: <u>40</u> feet Screen diameter: <u>476</u> inches Type of screen: <u>Munipack</u>							
Screen length: <u>40</u> feet Screen diameter: <u>446</u> inches Type of screen: <u>Munipack</u> Screen slot size: <u>, 010</u> inches Setting depth: From <u>325</u> feet to <u>365</u> feet							
Type of completion (check all applicable) ravel packed Underreamed Open hole Natural Development							
Other (describe):							
Top of lap pipe or reduction in casing: 250 feet							
If telescoped or more than one screen, describe on next page							

.


·

County: Jackson Permit #: <u>MS6W - 17316</u>

The sketch below only required for water wells

If well telescopes, show depths on sketch.

Ground Level

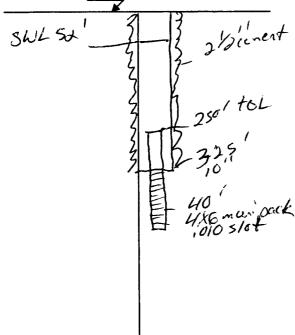

n na transferia Na Aliana Na Aliana			For Office Use Only:
C. S. M.	20	003 6.07	?Well #: <u>Q636</u>

Description of formations encountered must be provided for all wells and boreholes, unless specifically exempted by regulations

Description of Formations Encountered	From (<i>depth</i>) Ground level	To (depth)
Sard	Ground level	30
Clar	30	80
JARO	80	209
Clay	205	280
Fine Sund Clay	280	300
Clay	300	325 365
Sand	325	365
	-	
		<u></u>

If more than one screen, show location of each on sketch

Sketch the property layout and include the following:

1) the well location

2) any permanent structures on the property that may aid in locating the well

3) any roads, power lines, or other items that may aid in locating the property and the well

4) north arrow

See Map

Jackson County Port Authority Landowner Name:

I HEREBY CERTIFY that the well/borehole was drilled, constructed, and completed in accordance with all applicable requirements of the Mississippi Department of Environmental Quality and the Mississippi Department of Health regulations, if applicable, and state laws.

Josh Ladner 0-640 Print Name of Responsible Licensee and License No. Signature of Licensee Date Form: OLWR-SWR-1B (4/13)

STATE WELL REPORT						
County: Jackson	Pa	art 2				
	Pump Installer's	Completion Report	For Office Use Only:			
Permit #: $M564 - 17326$		t of Environmental Quality	Aquifer:			
		nd Water Resources				
Driller: Lynan Well	P.O. Box 2309					
Date completed: <u>9/19/17</u>		, MS 39225	Well #: <u>Q0636</u>			
		961-5210	Elevation:			
Copy information from block on Part 1	(601)963	1-5228 (fax)				
This part of the report must be completed by a licensed water well contractor or a licensed pump installer. A copy of Part 1 of the report must be attached and both parts filed with the Department at the above address within 30 days of well completion.						
Well Owner Informat			I Location			
Owner Name: Jackson County Port Authority Mailing Address: 303.3 Pascaspula St		Latitude: 3020 '38.01 Longitude: 88°30 119, 334				
Mailing Address: 3033 Pascas	rula St	Method of Lat/Long (check one): Conventional Survey,				
		USGS quad, Hand-held GPS V, Survey-grade GPS				
<u>axayoula M5</u> City State	39567	<u>IR 1/4 IR 1/4 Sec 17 T 85 R 541</u>				
City State Zip Code		Distance Direction Nearest Town				
Telephone No. (228) 762-4041		Miles o	f			
Design Transformer	-	Dec	wer Type			
Pump Type Circle one			ircle one			
Air Lift Jet	Submersible	Diesel Engine Gasolir	ne Engine Natural Gas			
Bucket Piston	Turbine C	Electric Motor Hand	Tractor PTO			
Centrifugal Rotary	Flowing Well	f	(specify):			
Other (specify):		Horse Power Rating of Motor:				
Date Pump Installed: 10/19/17		Setting Depth: /05	feet			
100	Gallons Per Minute	Number of Stages:				
		· · · · · · · · · · · · · · · · · · ·				
Pump Test Data		4	asuring Water Level			
117107		C	ircle one			
Date Well Tested: /// ///						
Static Water Level (A): 52 Feet	Dalama I and Careford	Air Line <u>Electric Mea</u>	suring Line Steel Tape			
Static Water Level (A): 52 Feet	Below Land Surface	Other (specify):				
Pumping Water Level (B): <u>74</u> Feet	Below Land Surface	Outer (specify).				
Drawdown [(B) - (A)]:Feet	Below Land Surface	For flowing well, measured sl	nut in head:feet			
Test Pumping Rate: 150	Gallons Per Minute	Well yielded	GPM with a drawdown of			
Duration of Pump Test (minimum 4 hours):	<u> </u>	feet after	hours of pumping			
		I				
I HEREBY CERTIFY that the above statements are true to the best of my knowledge.						
	1-640					
Print Name of Pump Installer and License N	No. (if applicable)	Signature of Pump Ir	istaller			
			Form: OLWR-SWR-1B (04/08)			

