

WATER WELL DRILLERS LOG

Date: 7-28-60
 1/28
 Driller: WATER SUPPLY Co
 County: Jackson

(1) Owner of Land: F M J. Fehens
 (Name)

RFD Pascagoula Miss
 (Address)

(2) Location: NE 1/4 NW 1/4, Sec. 6 T75R54N


(3) Topography: (Hilly) (Flat) (Level)
 (distance) miles of (direction) (Nearest Town)

(4) Purpose of Well: Domestic
 (Domestic Irrigation, Industrial, Other)

Information upon completion of well:
 (1) Diameter: 1 1/4 and 2 inches.
 (2) Total Depth: 305 feet.
 (3) Water Level: 47.77 feet below top of ground.
 (4) Cased to: 30m Size
 (5) Screen: Size 1 1/4 Length 10
 (6) Were any formations sealed against pollution? Yes, no.

If YES depth of formation
 Why
 Drillers Remarks

Description & Color of Materials Sand, Clay, Red Clay, Shell, etc.	Thick- ness Feet	Depth Feet
0 SLUSH 21 MUD SAND		
43 SAND 94 MUD		
105 SAND 185 MUD		
210 Muddy sand 221 MUD		
246 MUD 224 STRAIGS		
273 SAND 278		
294 good sand 305		

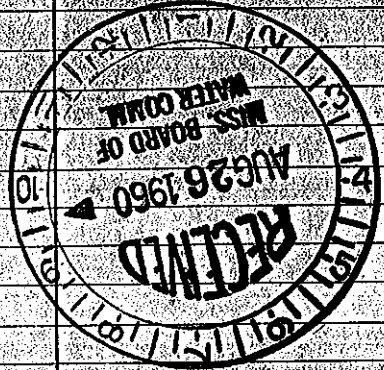

Well No. (Use Back Side)
 Mail this copy to Board of Water Commissioners 429 Miss. St. Jackson, Miss.