


Q 2000

WATER WELL DRILLERS LOG

6-4-62

Date: June 4, 1962, Driller: Andrew Colville County Jackson  
 (Name)

	Description & Color of Materials Sand, Clay, Red Clay, Shell, etc.	Thick- ness Feet	Depth Feet
(1) Owner of Land: <u>Ed Parker</u> (Name) <u>Wade Miss</u> (Address)	<u>0-20 clay</u>		
(2) Location: <u>NE 1/4, SW 1/4, Sec. 25 T5 R4W</u> <u>10</u> miles <u>South</u> , of <u>Wade</u> (distance) (direction) (Nearest Town)	<u>20-26 sand</u> <u>26-30 clay</u> <u>30-43 mud</u>		TD
(3) Topography: <u>Hilly</u> (Hilly) (Flat) (Level)			
(4) Purpose of Well: <u>Domestic</u> (Domestic Irrigation Municipal, Industrial, Other)			
Information upon completion of well:			
(1) Diameter <u>1 1/4</u> inches. <u>well 38 c u</u>			
(2) Total Depth: <u>43</u> feet.			
(3) Water Level: <u>16'</u> feet below top of ground.			
(4) Cased to <u>38</u> , Size _____			
(5) Screen: Size <u>1 1/4</u> , Length <u>5'</u>			
(6) Were any formations sealed against pollution?  _____ yes, <input checked="" type="checkbox"/> no.			
If YES depth of formation _____			
Why _____			
Drillers Remarks:     			

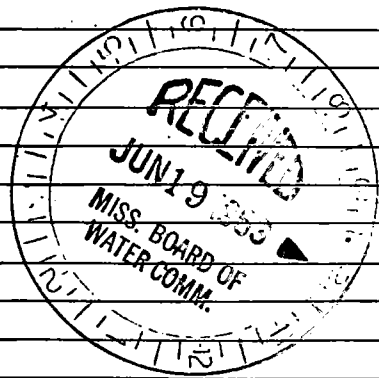

Well No. 153

(Use Back Side)

