

JACKSON MISSISSIPPI BOARD OF WATER COMMISSIONERS

Q 2001

7-11-63

WATER WELL DRILLERS LOG

Date: July 11 1963, Driller: L. L. Garland County: Jackson
 (Name)

(1) Owner of Land: H. C. McDuffey
 (Name)
Orange Grove, Miss.
 (Address)

(2) Location: 1/4, 1/4, Sec. T. 25N
9 miles East of Pascagoula
 (distance) (direction) (Town)

(3) Topography: Dom.
 (Hilly) (Flat) (Level)
 (Domestic Irrigation Municipal, Industrial, Other)

Description & Color of Materials Sand, Clay, Red Clay, Shell, etc.	Thick- ness Feet	Depth Feet
14' Clay	7'	14'
2 Sand		21'
3 Mix.		24'
4 Sand		28'
5 Mix.		33'
6 Sand		39'
7 15' S. 6' Mud		54'
8 Mud		60'
9 "		69'
10 "		79'
11 Sand		89'
12 Mud		101'
13 Mix.		116'
14 Mud		130'
15 "		145'
16 Mix.		161'
17 "		178'
18 "		196'
19 "		215'
20 17' Mix. 4' S.		232'
21 8' Sand		240'

Information upon completion of well:

(1) Diameter 8 inches. 418cc

(2) Total Depth 428 feet.

(3) Water Level 63 feet below top of ground.

(4) Cased to _____, Size _____


(5) Screen: Size 08, Length 10

(6) Were any formations sealed against pollution?
 _____ yes, _____ no.

If YES depth of formation _____

Why _____

Drillers Remarks: _____

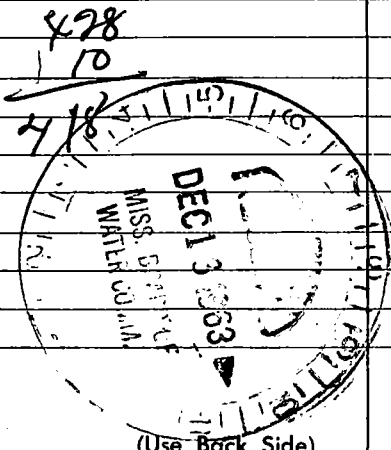

(Use Back Side)

Well No. _____

