

JACKSON MISSISSIPPI BOARD OF WATER COMMISSIONERS

Q 2002

7-15-63

WATER WELL DRILLERS LOG

Date: July 15 1963, Driller: L. L. Garland County Jackson  
(Name)

(1) Owner of Land:	Description & Color of Materials Sand, Clay, Red Clay, Shell, etc.	Thick- ness Feet	Depth Feet
Ed. Richards (Name)			
Bayou Cumbest (Address)	1 11' Clay 10' S.		
(2) Location: 1/4, 1/4, Sec. T. R. S.	2 19' S. 2' M.		
9 miles E. Passagoula (distance) (direction) (Nearest Town)	3 15' M. 6' S.		
(3) Topography:	4 Mix		
(Hilly) (Flat) (Level)	5 "		
(4) Purpose of Well: Dom. (Domestic Irrigation Municipal, Industrial, Other)	6 "		
	7 11' M. 10' S.		
	8 10' S. 11' M.		
	9 Mud		
	10 14' Mix. 7' S.		
	11 "		
	12 Sand		
	13 10' Sand		

Information upon completion of well:

(1) Diameter 2 inches.

(2) Total Depth 262 feet.

(3) Water Level 25 feet below top of ground.

(4) Cased to \_\_\_\_\_, Size \_\_\_\_\_.


(5) Screen: Size 08, Length 10'.

(6) Were any formations sealed against pollution?  
\_\_\_\_\_ yes, \_\_\_\_\_ no.

If YES depth of formation \_\_\_\_\_

Why \_\_\_\_\_

Drillers Remarks: \_\_\_\_\_

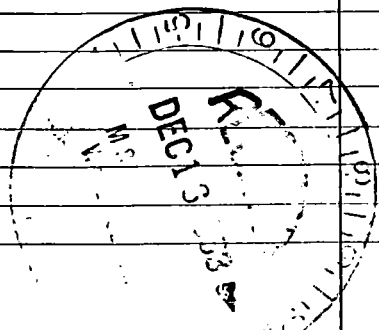

(Use Back Side)

Well No.

