

Jackson  
 Q 7005  
 10-3-75

MISSISSIPPI  
 BOARD OF WATER COMMISSIONERS  
 416 North State Street  
 Jackson, Mississippi 39201

WATER WELL DRILLERS LOG

Oct 3 1975 date well completed  
 Diff. Well Co firm name  
 Jackson county well located

LANDOWNER: H.H. Holland

description of formations encountered

from to

pt. 3

Roseburg Mills  
 (mailing address)

WELL LOCATION:

sec. 6 T 2 N R 5 E 13Q  
 1 1/2 miles N-E of Escatawpa  
 (distance) (direction) (nearest town)

WELL PURPOSE: Home  
 (home, irrigation, municipal, industrial)

WELL COMPLETION DATA:

- (1) diameter (inches) 2"
- (2) total depth (feet) 165'
- (3) static water level (feet) 12' below above top of ground.
- (4) casing PVC, 160' CL  
 (material) (depth)  
 If telescope see back.  
 (size)
- (5) screen 5' 160'  
 (length) (depth to top)  
 2" PVC  
 (size) (material)
- (6) pump 1 12  
 (HP) (yield gpm)  
 ole  
 (type power)
- (7) electric log no  
 (yes or no)  
 (organization running log)
- (8) how well bottom plugged B.W.V.


grey sand	0'	6'
yellow sand	6'	30'
light grey clay	20'	35'
coarse white sand	35'	50'
blue clay	55'	140'
fine to med grey sand	140'	165'
		140'

DRILLERS REMARKS:

RECEIVED  
 OCT 10 1975  
 MISSISSIPPI DEPARTMENT OF AGRICULTURE  
 COMM

If well telescopes please sketch and show depths.

GROUND LEVEL

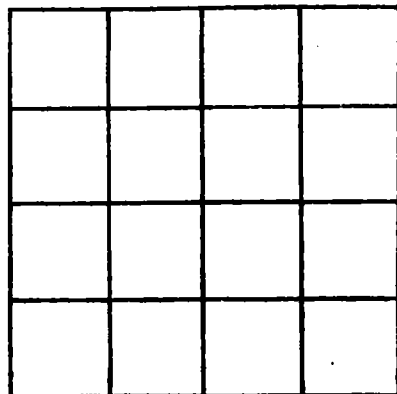

SECTION \_\_\_\_\_

Please indicate well location X.

ADDITIONAL INFORMATION

If more than one screen, show locations of each on sketch.