

Jackson  
 Q 2006  
 9-3-75

MISSISSIPPI  
 BOARD OF WATER COMMISSIONERS  
 416 North State Street  
 Jackson, Mississippi 39201


WATER WELL DRILLERS LOG

Sept 3 1975 Chalk Water Dry Jackson  
 date well completed firm name county well located

| LANDOWNER: <u>Bull</u>                                                                | description of formations encountered | from       | to         |
|---------------------------------------------------------------------------------------|---------------------------------------|------------|------------|
| <u>Stork</u>                                                                          |                                       |            |            |
| <u>Bayou Lumbeant</u><br>(mailing address)                                            | <u>sandy clay</u>                     | <u>0</u>   | <u>27</u>  |
|                                                                                       | <u>soft blue clay</u>                 | <u>27</u>  | <u>87</u>  |
|                                                                                       | <u>sand</u>                           | <u>87</u>  | <u>176</u> |
|                                                                                       | <u>clay</u>                           | <u>176</u> | <u>198</u> |
|                                                                                       | <u>sand</u>                           | <u>198</u> | <u>265</u> |
| WELL LOCATION:<br>sec <u>35</u> T <u>7</u> N R <u>5</u> <sup>13R</sup>                |                                       |            |            |
| <u>6</u> miles <u>SE</u> of <u>Mer Rouge</u><br>(distance) (direction) (nearest town) |                                       |            |            |
| WELL PURPOSE: <u>home</u><br>(home, irrigation, municipal, industrial)                |                                       |            |            |
| WELL COMPLETION DATA:<br>(1) diameter (inches) <u>2</u>                               |                                       |            |            |
| (2) total depth (feet) <u>265</u>                                                     |                                       |            |            |
| (3) static water level (feet) <u>45</u> <sup>below</sup> above top of ground          |                                       |            |            |
| (4) casing <u>plast</u> , <u>260</u> ,<br>(material) (depth)                          |                                       |            |            |
| _____ If telescope see back.<br>(size)                                                |                                       |            |            |
| (5) screen <u>5'</u> , <u>260</u><br>(length) (depth to top)                          |                                       |            |            |
| <u>2"</u> , <u>plast</u><br>(size) (material)                                         |                                       |            |            |
| (6) pump <u>3/4</u> , <u>8</u><br>(HP) (yield gpm)                                    |                                       |            |            |
| <u>elec</u><br>(type power)                                                           |                                       |            |            |
| (7) electric log <u>no</u><br>(yes or no)                                             |                                       |            |            |
| _____ (organization running log)                                                      |                                       |            |            |
| (8) how well bottom plugged <u>BP. Well</u>                                           |                                       |            |            |
| DRILLERS REMARKS:                                                                     |                                       |            |            |

If well telescopes please sketch and show depths.

GROUND LEVEL

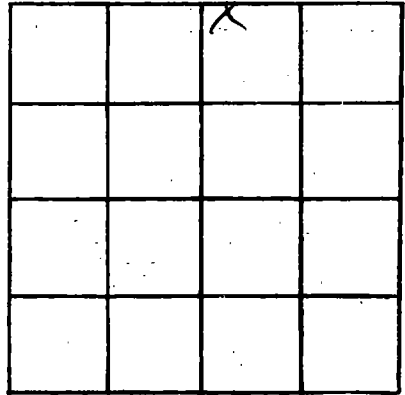

SECTION 35

Please indicate well location X:

ADDITIONAL INFORMATION

A series of horizontal lines providing space for additional information.

If more than one screen, show locations of each on sketch.