

Jackson
Q 2007
10-5-75

MISSISSIPPI
 BOARD OF WATER COMMISSIONERS
 416 North State Street
 Jackson, Mississippi 39201


WATER WELL DRILLERS LOG

Oct 5 1975 Phillips Waterbury Jackson
 date well completed firm name county well located

| LANDOWNER: | description of formations encountered | from | to |
|--|---|--|---|
| <u>Gene Requin</u> <u>Passagula Ms</u> (mailing address) | <u>sandy clay</u> <u>soft blue clay</u> <u>sand</u> <u>clay</u> <u>sand</u> | <u>0</u> <u>22</u> <u>60</u> <u>180</u> <u>195</u> | <u>22</u> <u>60</u> <u>180</u> <u>195</u> <u>24</u> |
| WELL LOCATION: sec. <u>32</u> T. <u>7</u> N. R. <u>5</u> E. <u>13a</u> <u>4</u> miles (distance) <u>East</u> (direction) of <u>East Park</u> (nearest town) | | | |
| WELL PURPOSE: <u>Machine Shop</u> (home, irrigation, municipal, industrial) | | | |
| WELL COMPLETION DATA: | | | |
| (1) diameter (inches) <u>2</u> | | | |
| (2) total depth (feet) <u>305</u> | | | |
| (3) static water level (feet) <u>100</u> <u>below</u> top of ground | | | |
| (4) casing <u>plst</u> <u>300</u> (material) (depth) | | | |
| (size) _____ if telescope see back. | | | |
| (5) screen <u>5</u> <u>300</u> (length) (depth to top) | | | |
| (size) <u>2"</u> (material) <u>plst</u> | | | |
| (6) pump <u>2</u> <u>8</u> (HP) (yield gpm) | | | |
| (type power) <u>elec</u> | | | |
| (7) electric log <u>no</u> (yes or no) | | | |
| (organization running log) _____ | | | |
| (8) how well bottom plugged <u>B/W clay</u> | | | |
| DRILLERS REMARKS: | | | |

If well telescopes please sketch and show depths.

GROUND LEVEL

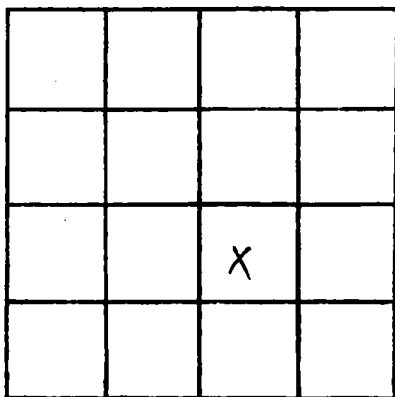

SECTION 32

Please indicate well location X.

ADDITIONAL INFORMATION

A series of horizontal lines for writing additional information, starting below the 'ADDITIONAL INFORMATION' header and extending to the bottom of the page.

If more than one screen, show locations of each on sketch.