

JACKSON  
Q 2008  
12-11-75

MISSISSIPPI  
BOARD OF WATER COMMISSIONERS  
416 North State Street  
13Q Jackson, Mississippi 39201

WATER WELL DRILLERS LOG  
COAST WATER WELL SERVICE INC.

12/11 1975 date well completed      firm name      Jackson county well located

LANDOWNER: C. L. Harney  
Rt. 1 Box 521  
Pascagoula, Ms.  
(mailing address)

WELL LOCATION:  
sec. 22 T. 7 R. 5  
in S of W  
Kresle  
(distance) miles (direction) of (nearest town)

WELL PURPOSE: Home  
(home, irrigation, municipal, industrial)

- WELL COMPLETION DATA:
- (1) diameter (inches) 2"
  - (2) total depth (feet) 247'
  - (3) static water level (feet) 24 <sup>below</sup> ~~above~~ top of ground.
  - (4) casing PVC 237'  
(material) (depth)  
2" if telescope see back.  
(size)
  - (5) screen 10' 237'  
(length) (depth to top)  
2" PVC  
(size) (material)
  - (6) pump 1 9  
(HP) (yield gpm)  
elec.  
(type power)
  - (7) electric log NO  
(yes or no)
  - (organization running log)
  - (8) how well bottom plugged B.W.U.


description of formations encountered	from	to
<u>top soil</u>	<u>0</u>	<u>10</u>
<u>Blue clay</u>	<u>10</u>	<u>18</u>
<u>(C) Sand + gravel</u>	<u>18</u>	<u>123</u>
<u>Blue clay</u>	<u>123</u>	<u>150</u>
<u>Sand (C)</u>	<u>150</u>	<u>247</u>

DRILLERS REMARKS:

RECEIVED  
APR - 3 1976

If well telescopes please sketch and show depths.

GROUND LEVEL

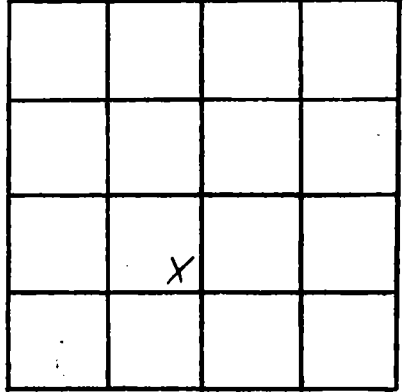

SECTION 22

Please indicate well location X.

ADDITIONAL INFORMATION

If more than one screen,  
show locations of each on sketch.