

JACKSON
 @ 2015
 12/7/76

MISSISSIPPI
 BOARD OF WATER COMMISSIONERS
 416 North State Street
 Jackson, Mississippi 39201

WATER WELL DRILLERS LOG

Dec. 7 1976 date well completed
 Colville Drilling Co firm name
 Jackson county well located

LANDOWNER:	description of formations encountered	from	to
Alton Ready	Sandy clay sand clay sand	0	15
Orange Grove (mailing address)		15	180
WELL LOCATION:		180	188
sec. 23 T-7 N R-5 E 4 miles NE of MP. (distance) (direction) (nearest town)		188	240
WELL PURPOSE: Home (home, irrigation, municipal, industrial)			
WELL COMPLETION DATA:			
(1) diameter (inches) 2 in			
(2) total depth (feet) 240 ft			
(3) static water level (feet) 30 below top of ground			
(4) casing plastic 2 1/2" (material) (depth)			
2" (size) if telescope see back.			
(5) screen plastic 255 (length) (depth to top)			
2" plastic (size) (material)			
(6) pump 1 HP 10 (HP) (yield gpm)			
elec. (type power)			
(7) electric log no (yes or no)			
(organization running log)			
(8) how well bottom plugged BP value			
DRILLERS REMARKS:			


RECEIVED

MAR 14 1977

MISS. BD. OF WATER COMM

If well telescopes please sketch and show depths.

GROUND LEVEL

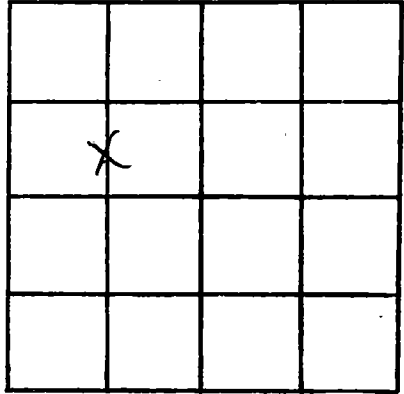

SECTION 23

Please indicate well location X.

ADDITIONAL INFORMATION

If more than one screen, show locations of each on sketch.