

Jackson
 Q 2017
 12/30/76

MISSISSIPPI
 BOARD OF WATER COMMISSIONERS
 416 North State Street
 138 Jackson, Mississippi 39201

WATER WELL DRILLERS LOG

Dec 30 1976 Calville Drilling Co. Jackson
 date well completed firm name county well located

LANDOWNER: <u>George</u> <u>B. Roman</u>	description of formations encountered	from	to
H. Wolfe, M.S. (mailing address)	sandy clay soft blue clay sand	0 10 30	10 30 190
WELL LOCATION: sec. <u>4</u> T. <u>8</u> N. R. <u>5</u> E <u>2</u> miles (distance) <u>S</u> (direction) of <u>Rowle</u> (nearest town)	clay sand	190 195	195 254
WELL PURPOSE: <u>home</u> (home, irrigation, municipal, industrial)			
WELL COMPLETION DATA:			
(1) diameter (inches) <u>2"</u>			
(2) total depth (feet) <u>254</u>			
(3) static water level (feet) <u>60</u> ^{below} <u>above</u> top of ground.			
(4) casing <u>plastic</u> <u>249</u> (material) (depth)			
<u>2"</u> If telescope see back. (size)			
(5) screen <u>5'</u> <u>249</u> (length) (depth to top)			
<u>2"</u> <u>plastic</u> (size) (material)			
(6) pump <u>1</u> <u>8</u> (HP) (yield gpm)			
<u>velec</u> (type power)			
(7) electric log <u>no</u> (yes or no)			
_____ (organization running log)			
(8) how well bottom plugged <u>B.P. Valve</u>			
DRILLERS REMARKS:			


RECEIVED

JAN 24 1977

MISS. BD. OF WATER COMM

If well telescopes please sketch and show depths.

GROUND LEVEL

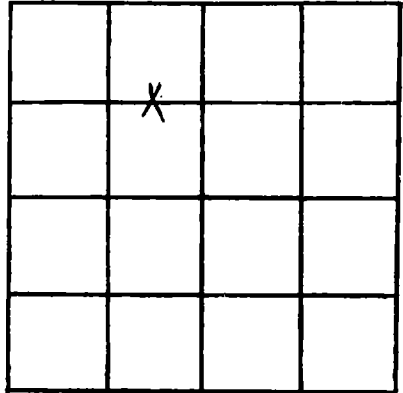

SECTION 4

Please indicate well location X.

ADDITIONAL INFORMATION

If more than one screen, show locations of each on sketch.