

JACKSON
 @ 2018

MISSISSIPPI
 BOARD OF WATER COMMISSIONERS
 416 North State Street
 Jackson, Mississippi 39201

WATER WELL DRILLERS LOG

5-15 1978 Colville Drilling Co. Jackson
 date well completed firm name county well located

LANDOWNER: Alex Meredith
 Bryan Cumbs, Ms.
 (mailing address)

description of formations encountered	from	to
Clay	0	15
sand	15	66
Clay	66	80
sand	80	170
Clay	170	198
sand	198	261

WELL LOCATION:
 sec 25 T 7 N R 5 E
 (distance) (direction) (nearest town)
 6 miles east of Mosheim

WELL PURPOSE: Fishing Camp
 (home, irrigation, municipal, industrial)

- WELL COMPLETION DATA:
- (1) diameter (inches) 2"
 - (2) total depth (feet) 261
 - (3) static water level (feet) 35 above top of ground
 - (4) casing plastic, 256 (material) (depth)
 2" (size) if telescope see back.
 - (5) screen 5 ft., 256 (length) (depth to top)
 2" plastic (size) (material)
 - (6) pump 1 (HP) 20 (yield gpm)
 electric (type power)
 - (7) electric log no (yes or no)
 (organization running log)
 - (8) how well bottom plugged back
 wash wash


RECEIVED
 JUN 14 1978

MISS. BD. OF WATER COMMISSIONERS

DRILLERS REMARKS:

If well telescopes please sketch and show depths.

GROUND LEVEL

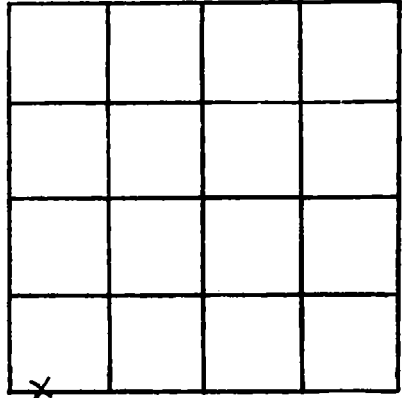

SECTION 25

Please indicate well location X.

ADDITIONAL INFORMATION

If more than one screen, show locations of each on sketch.