

JACKSON  
 09021  
 8-23-78

MISSISSIPPI  
 BOARD OF WATER COMMISSIONERS  
 416 North State Street  
 Jackson, Mississippi 39201

WATER WELL DRILLERS LOG

8-23 1978 Coast Water Well Serv. Inc. Jackson  
 date well completed firm name county well located

LANDOWNER:	description of formations encountered	from	to
Henry Ping P.O. Box 5087	Top soil	0	5
Kneale Mrs. 39563 (mailing address)	Blue Clay	5	30
WELL LOCATION: sec. 34 T 7 S R 5 W (distance) miles in (direction) of Kneale (nearest town)	White coarse sand	30	81
WELL PURPOSE: Home (home, irrigation, municipal, industrial)	Blue Clay	81	113
WELL COMPLETION DATA: (1) diameter (inches) 2" (2) total depth (feet) 250 (3) static water level (feet) 56' below top of ground (4) casing PVC (material), (depth) 2" (size) if telescope see back. (5) screen 10' (length), 240' (depth to top), 2" (size), PVC (material) (6) pump 1/2 HP (HP), 9 (yield gpm), Elec. (type power) (7) electric log No (yes or no) (organization running log) (8) how well bottom plugged, back wash valve	Gray coarse sand + gravel	113	175
	Blue Clay	175	213
	Gray coarse sand	215	250
DRILLERS REMARKS:			


RECEIVED

NOV - 9 1978

MISS. DD. OF WATER COMM

If well telescopes please sketch and show depths.

**GROUND LEVEL**

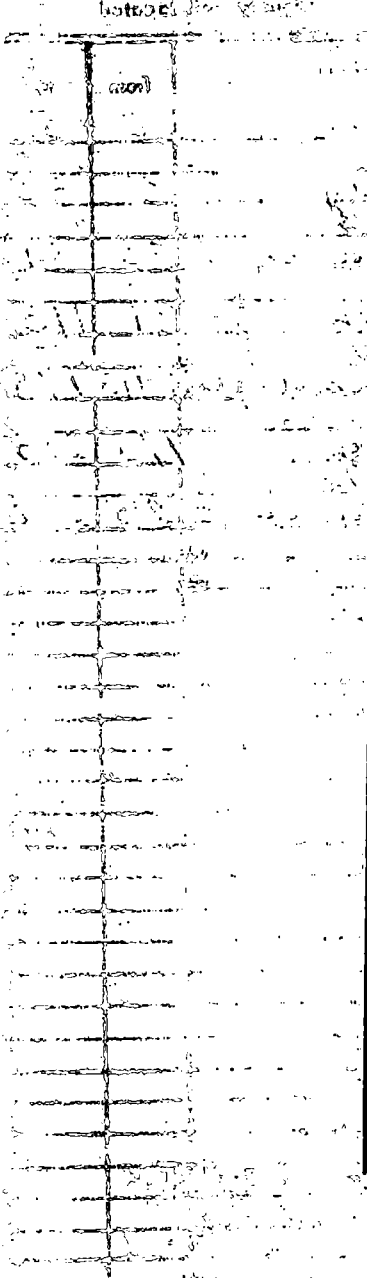

X			

**SECTION** 34

Please indicate well location X:

**ADDITIONAL INFORMATION**


If more than one screen, show locations of each on sketch.