

JACKSON
 Q 7073
 10-13-78

MISSISSIPPI
 BOARD OF WATER COMMISSIONERS
 416 North State Street
 Jackson, Mississippi 39201

WATER WELL DRILLERS LOG

10-13-78 date well completed
 1978 Wash Water Well Drilling firm name
 Jackson county well located

LANDOWNER: Louise King
P.O. Box 70
Escatawpa, Miss.
 (mailing address)

description of formations encountered	from	to
Top soil	0	10
White coarse sand	10	41
White coarse sand + wood	41	84
White coarse sand + gravel	84	160
Blue Clay	160	235
Gray coarse sand	235	273


WELL LOCATION:
 sec. 35 T. 7 S. R. 5 W.
5 miles East Pascagoula
 (distance) (direction) (nearest town)

WELL PURPOSE: Home
 (home, irrigation, municipal, industrial)

WELL COMPLETION DATA:
 (1) diameter (inches) 2"
 (2) total depth (feet) 273'
 (3) static water level (feet) 35 ^{below} _{above} top of ground.
 (4) casing PVC 263
 (material) (depth)
2" if telescope see back.
 (size)
 (5) screen 10' 263
 (length) (depth to top)
2" PVC
 (size) (material)
 (6) pump 3/4 hp. 8
 (HPY) (yield gpm)
Elect
 (type power)
 (7) electric log No.
 (yes or no)
 (organization running log)

(8) How well bottom plugged: back wash valve

DRILLERS REMARKS:

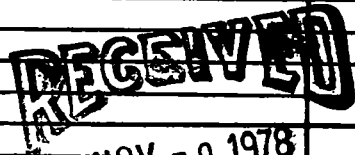

NOV - 9 1978

MISS. BD. OF WATER COMMISSIONERS

If well telescopes, please sketch and show depths.

GROUND LEVEL

			X

SECTION 35

Please indicate well location X.

ADDITIONAL INFORMATION

If more than one screen, show locations of each on sketch.