

JACKSON
 Q 2024
 10-17-78

MISSISSIPPI
 BOARD OF WATER COMMISSIONERS
 416 North State Street
 Jackson, Mississippi 39201


WATER WELL DRILLERS LOG

10-17-78 date well completed 1978 Cash Water Well Drilling, Inc. firm name Jackson county well located

LANDOWNER: Clarence Johnson
 4005 Short Cut Rd.
 Pascagoula Miss.
 (mailing address) 39367

description of formations encountered	from	to
Top soil	0	1
Red Clay	1	10
White Coarse sand	10	38
White Coarse sand + Wood	38	44
Gray Clay	44	60
White Coarse sand + Gravel	60	145
Blue Clay	145	226
Gray Coarse sand	226	280

WELL LOCATION:

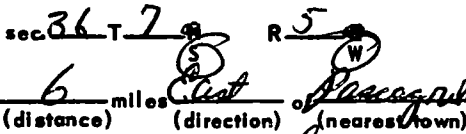

WELL PURPOSE: Home
 (home, irrigation, municipal, industrial)

WELL COMPLETION DATA:

- (1) diameter (inches) 2"
- (2) total depth (feet) 280'
- (3) static water level (feet) 31' ^{below} top of ground.
- (4) casing PVC (material), 270' (depth)
 2" (size) If telescope see back.
- (5) screen 10' (length), 270' (depth to top)
 2" (size), PVC (material)
- (6) pump 1/2 hp. (HP), 10 (yield gpm)
 Elec. (type power)
- (7) electric log No (yes or no)

(8) how well bottom plugged
 back wash valve

DRILLERS REMARKS:

RECEIVED

NOV - 9 1978

If well telescopes please sketch and show depths.

GROUND LEVEL

X			

SECTION 36

Please indicate well location X.

ADDITIONAL INFORMATION

If more than one screen, show locations of each on sketch.