

JACKSON
 Q 2030
 3-29-77

MISSISSIPPI
 BOARD OF WATER COMMISSIONERS
 416 North State Street
 Jackson, Mississippi 39201

WATER WELL DRILLERS LOG

3-29-77 19 Cast Water Well Sew Inc. Jackson
 date well completed firm name county well located

LANDOWNER Dickson Home Inc
Highway 90
Gautier, Miss. 39553
 (mailing address)

WELL LOCATION:
 sec 36 T 7 R 15
6 miles East of Pascagoula
 (distance) (direction) (nearest town)

WELL PURPOSE: Supply
 (home, irrigation, municipal/ industrial)

- WELL COMPLETION DATA:
- (1) diameter (inches) 2"
 - (2) total depth (feet) 508'
 - (3) static water level (feet) 30' below top of ground.
 - (4) casing PVC 508'
 (material) (depth)
2" If telescope see back.
 (size)
 - (5) screen 10' 508'
 (length) (depth to top)
2 PVC
 (size) (material)
 - (6) pump 1 hp. 8 gal.
 (HP) (yield/gpm)
elec.
 (type power)
 - (7) electric log No.
 (yes or no)
 (organization running log)
 - (8) how well bottom plugged
back wash

description of formations encountered	from to	
Top soil	0	20
Coarse sand	20	50
Blue Clay	50	65
Coarse sand	65	80
Blue Clay	80	190
Fine to coarse sand	190	260
Blue Clay	260	280
Med. Sand	280	300
Blue Clay	300	470
Med. to coarse sand & gravel	470	518

RECEIVED


SEP 21 1977

MISS. BD. OF WATER COMM

DRILLERS REMARKS:

If well telescopes please sketch and show depths.

GROUND LEVEL

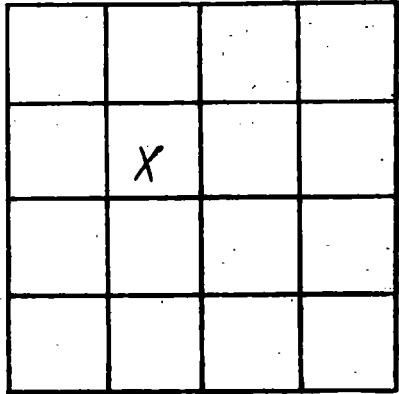

SECTION 36

Please indicate well location X.

ADDITIONAL INFORMATION

If more than one screen, show locations of each on sketch.