

JACKSON  
 @ 2071  
 3-17-77

MISSISSIPPI  
 BOARD OF WATER COMMISSIONERS  
 416 North State Street  
 Jackson, Mississippi 39201

X

WATER WELL DRILLERS LOG

3-17 19 77 Coast Water Well Sew. Jackson  
 date well completed firm name county well located

LANDOWNER: Sonny Backe  
Rt 1 Box 910  
Pascagoula, Miss 39563  
 (mailing address)

description of formations encountered	from	to
top soil	0	2
gray clay	2	11
sand + gravel	11	53
blue clay	53	60
sand + gravel	60	144
blue clay	144	158
med-to coarse sand	158	238

WELL LOCATION:  
 sec 14 T 7 R 5  
6 2 1/2 miles East of Passapatan  
 (distance) (direction) (nearest town)

WELL PURPOSE: Home  
 (home, irrigation, municipal, industrial)


WELL COMPLETION DATA:  
 (1) diameter (inches) 2"  
 (2) total depth (feet) 238'  
 (3) static water level (feet) 20 <sup>below</sup> <sub>above</sub> top of ground.  
 (4) casing PVC 228'  
 (material) (depth)  
2 (size) if telescope see back.  
 (5) screen 10' 228'  
 (length) (depth to top)  
2 PVC  
 (size) (material)  
 (6) pump 1/2 hp 7 gpm  
 (HP) (yield/gpm)  
elec.  
 (type power)  
 (7) electric log No  
 (yes or no)  
 (organization running log)  
 (8) how well bottom plugged Backwash  
Value

DRILLERS REMARKS:

RECEIVED  
 SEP 21 1977

If well telescopes please sketch and show depths.

GROUND LEVEL

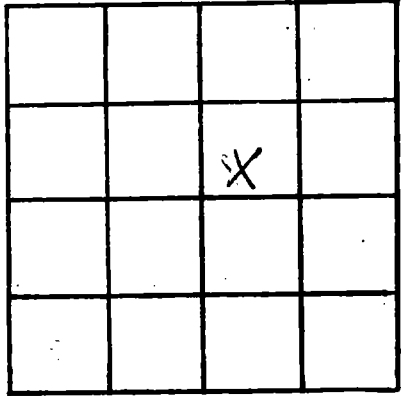

SECTION 14

Please indicate well location X.

ADDITIONAL INFORMATION

If more than one screen, show locations of each on sketch.