

JACKSON  
Q 2032  
4-21-77

MISSISSIPPI  
BOARD OF WATER COMMISSIONERS  
416 North State Street  
Jackson, Mississippi 39201

WATER WELL DRILLERS LOG

4-21 1977 *Coast Water Well Sew.* Jackson  
date well completed firm name county well located

LANDOWNER: *Frank Stork*  
*Rt #1 Box 212*  
*Pascagoula Miss 39567*  
(mailing address)

WELL LOCATION:  
sec. *18* T. *7* R. *4*  
*8* miles *E.* of *Miss Point*  
(distance) (direction) (nearest town)

WELL PURPOSE: *Supply*  
(home, irrigation, municipal, industrial)

WELL COMPLETION DATA:  
(1) diameter (inches) *2"*  
(2) total depth (feet) *185'*  
(3) static water level (feet) *40'* below above  
top of ground.  
(4) casing *PVC* *115'*  
(material) (depth)  
*2"*  
(size) If telescope see back.  
(5) screen *10'* *175'*  
(length) (depth to top)  
*2"* *PVC*  
(size) (material)  
(6) pump *1/2* *6*  
(HP) (yield gpm)  
*Elec.*  
(type power)  
(7) electric log *No*  
(yes or no)  
(organization running log)

description of formations encountered	from	to
<i>Top soil</i>	<i>0</i>	<i>1</i>
<i>Grey Clay</i>	<i>1</i>	<i>8</i>
<i>Sand - coarse</i>	<i>8</i>	<i>22</i>
<i>Sand grey clay</i>	<i>22</i>	<i>80</i>
<i>Blue Clay</i>	<i>80</i>	<i>119</i>
<i>Sand - (med.)</i>	<i>119</i>	<i>140</i>
<i>Blue Clay</i>	<i>140</i>	<i>145</i>
<i>Sand (med.)</i>	<i>145</i>	<i>185</i>

(8) how well bottom plugged  
*Back Wash Valve*

DRILLERS REMARKS:


**RECEIVED**

SEP 21 1977

MISS. BD. OF WATER COMM

If well telescopes please sketch and show depths.

GROUND LEVEL

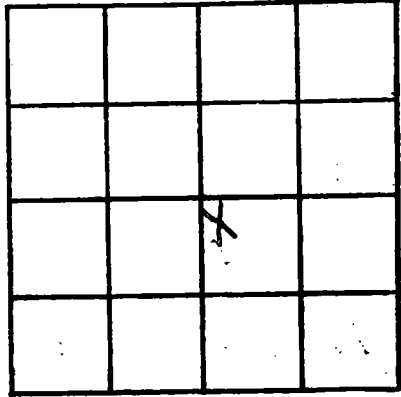

SECTION 18

Please indicate well location X.

ADDITIONAL INFORMATION

If more than one screen, show locations of each on sketch.