

JACKSON  
 Q 2034  
 5-15-77

MISSISSIPPI  
 BOARD OF WATER COMMISSIONERS  
 416 North State Street  
 Jackson, Mississippi 39201

WATER WELL DRILLERS LOG

JACKSON

5-15 1977  
 date well completed

135

Jackson, Mississippi 39201

77 Colville Water Supply  
 firm name

Orange  
 county well located

| LANDOWNER: <u>Foster</u>   | description of formations encountered | from       | to         |
|--|---------------------------------------|------------|------------|
| <u>Trailer Park</u>  |                                       |            |            |
| <u>Orange Grove M.</u><br>(mailing address)  | <u>50 ft. clay</u>                    | <u>0</u>   | <u>30</u>  |
|  | <u>sand 30' &amp; gravel</u>          | <u>30</u>  | <u>152</u> |
|  | <u>clay</u>                           | <u>152</u> | <u>172</u> |
|  | <u>sand</u>                           | <u>172</u> | <u>240</u> |
| WELL LOCATION:<br>sec. <u>23</u> T. <u>7</u> N. R. <u>5</u> E. (W) <u>1</u><br><del>242</del> miles <u>E</u> of <u>BP</u><br>(distance) (direction) (nearest town) |                                       |            |            |
| WELL PURPOSE: <u>Trailer Park</u><br>(home, irrigation, municipal, industrial)   |                                       |            |            |
| WELL COMPLETION DATA:  |                                       |            |            |
| (1) diameter (inches) <u>2 in</u>  |                                       |            |            |
| (2) total depth (feet) <u>240 ft</u>   |                                       |            |            |
| (3) static water level (feet) <u>2</u> <u>below</u> top of ground.   |                                       |            |            |
| (4) casing <u>PVC</u> , <u>235</u> ,<br>(material) (depth)   |                                       |            |            |
| (size) If telescope see back.  |                                       |            |            |
| (5) screen <u>5'</u> , <u>235</u><br>(length) (depth to top)   |                                       |            |            |
| <u>2"</u> , <u>PVC</u><br>(size) (material)  |                                       |            |            |
| (6) pump <u>1</u> <u>10</u><br>(HP) (yield gpm)  |                                       |            |            |
| <u>elec</u><br>(type power)  |                                       |            |            |
| (7) electric log <u>no</u><br>(yes or no)  |                                       |            |            |
| (organization running log)   |                                       |            |            |
| (8) how well bottom plugged <u>BP Valve</u>  |                                       |            |            |


RECEIVED  
 JUN 9 1977

MISS. RD. OF WATER COMM.

DRILLERS REMARKS:

If well telescopes please sketch and show depths.

GROUND LEVEL

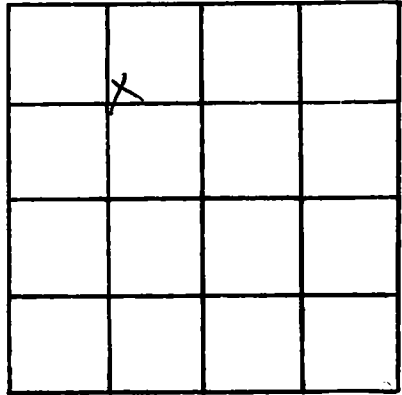

SECTION R3

Please indicate well location X.

ADDITIONAL INFORMATION

If more than one screen, show locations of each on sketch.