

JACKSON
Q 7035
May 20, 1977

MISSISSIPPI
BOARD OF WATER COMMISSIONERS
416 North State Street
Jackson, Mississippi 39201

WATER WELL DRILLERS LOG


May 20 1977 date well completed
130 77 Belleville Drilling Co. firm name
Jackson County county well located

LANDOWNER	description of formations encountered	from	to
Homer Muffin Danny Grove (mailing address)	clay sand clay sand	0 15 176 185	15 176 185 230
WELL LOCATION: sec. 20 T. 7 N. R. 5 E. 2 1/2 miles (distance) of (direction) of (nearest town) MP			
WELL PURPOSE: home (home, irrigation, municipal, industrial)			
WELL COMPLETION DATA: (1) diameter (inches) 2 in (2) total depth (feet) 235 ft. (3) static water level (feet) 35 below above top of ground. (4) casing plastic 230 (material) (depth) 2 in (size) if telescope see back. (5) screen 5' 230' (length) (depth to top) 2 in (size) (material) (6) pump 1 (HP) 10 (yield gpm) elect (type power) (7) electric log no (yes or no) (organization running log) (8) how well bottom plugged			
DRILLERS REMARKS:			

RECEIVED
 JUL 28 1977
 MISS. BD OF WATER COM.

If well telescopes please sketch and show depths.

GROUND LEVEL

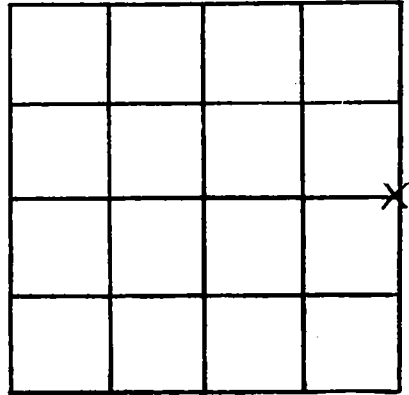

SECTION 22

Please indicate well location X.

ADDITIONAL INFORMATION

If more than one screen, show locations of each on sketch.