

JACKSON

Q 2071

MISSISSIPPI BOARD OF WATER COMMISSIONERS
416 North State Street
Jackson, Mississippi 39201

WATER WELL DRILLERS LOG

4-24 date well completed

1978 East Water Well Serv. Inc. firm name

Jackson county well located

LANDOWNER

Alton Brown

description of formations encountered

from

to

Box 970
Pascagoula, Miss.
(mailing address)

Top Soil

0 4

Red Clay

4 20

Gray Coarse Sand

20 139

Blue Clay

139 164

Gray Coarse Sand

164 240

WELL LOCATION:

sec. 23 T 7 R 5 W
3 miles East of Moss Point
(distance) (direction) (nearest town)

WELL PURPOSE:

(home, irrigation, municipal, industrial)

WELL COMPLETION DATA:

- (1) diameter (inches) 2"
- (2) total depth (feet) 240'
- (3) static water level (feet) 36' below top of ground
- (4) casing PVC, 230' (material) (depth)
2" (size) if telescope see back.
- (5) screen 10' 230' (length) (depth to top)
2" PVC (size) (material)
- (6) pump 1 HP 2 (HP) (yield gpm)
Elec (type power)
- (7) electric log No (yes or no)

(organization running log)

(8) how well bottom plugged
back wash valve


DRILLERS REMARKS:

RECEIVED
AUG - 4 1978

MISS. BD. OF WATER COMM

If well telescopes please sketch and show depths.

GROUND LEVEL

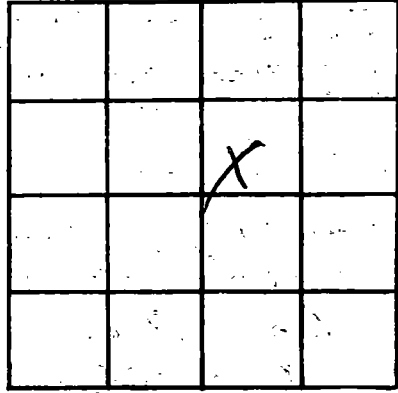

SECTION 23

Please indicate well location X.

ADDITIONAL INFORMATION

If more than one screen, show locations of each on sketch.