

JACKSON

MISSISSIPPI  
BOARD OF WATER COMMISSIONERS  
416 North State Street  
Jackson, Mississippi 39201

WATER WELL DRILLERS LOG

April 24 1978  
date well completed

Griffin Well Co  
firm name

Jackson  
county well located

LANDOWNER:

Andrew Malletto

Rt. 1 Pascagoula Miss  
(mail/fg address)

WELL LOCATION:

sec. 22 T 7 N R 5 E  
1/4 miles West of Orange Grove  
(distance) (direction) (nearest town)

WELL PURPOSE:

Home  
(home, irrigation, municipal, industrial)

WELL COMPLETION DATA:


- (1) diameter (inches) 2"
- (2) total depth (feet) 215'
- (3) static water level (feet) 44' below top of ground
- (4) casing PVC, 210' (depth)  
(size) if telescope see back.
- (5) screen 5' length, 210' depth to top  
(size) (material)
- (6) pump 1 HP, 10 yield gpm  
ela (type power)
- (7) electric log no (yes or no)  
(organization running log)
- (8) how well bottom plugged Rev. U.

description of formations encountered

from to

silt	0'	15'
Coarse sand	15'	50'
blue clay	50'	105'
sand	105'	140'
Blue Clay	140'	185'
gray sand	185'	215'

DRILLERS REMARKS:

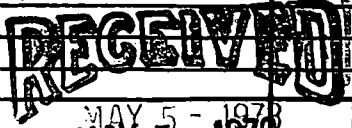

If well telescopes please sketch and show depths.

GROUND LEVEL


SECTION \_\_\_\_\_

Please indicate well location X.

ADDITIONAL INFORMATION

If more than one screen, show locations of each on sketch.