

JACKSON
 02044
 9-11-78

MISSISSIPPI
 BOARD OF WATER COMMISSIONERS
 416 North State Street
 Jackson, Mississippi 39201

WATER WELL DRILLERS LOG

Sept 11th 1978 Coast Water Well Service Jackson
 date well completed firm name county well located

LANDOWNER: Willie Maples
P.O. Box 5266
Kreole Station - Kreole
 (mailing address) Miss.

WELL LOCATION:
 sec. 28 T. 7 N. R. 5 E.
(S) (W)
 miles in of Kreole
 (distance) (direction) (nearest town)

WELL PURPOSE: Home
 (home, irrigation, municipal, industrial)

WELL COMPLETION DATA:

(1) diameter (inches) 2"

(2) total depth (feet) 247'

(3) static water level (feet) 54' ^{below} _{above} top of ground.

(4) casing PVC 237'
 (material) (depth)

2"
 (size) if telescope see back.

(5) screen 10' 237'
 (length) (depth to top)

2" PVC
 (size) (material)

(6) pump 1 h.p. 8.5
 (HP) (yield gpm)

Elec.
 (type power)


(7) electric log No
 (yes or no)

(organization running log)

description of formations encountered	from	to
<u>Top soil</u>	<u>0</u>	<u>2</u>
<u>Red clay</u>	<u>2</u>	<u>10</u>
<u>Blue clay</u>	<u>10</u>	<u>30</u>
<u>White coarse sand</u>	<u>30</u>	<u>63</u>
<u>Blue clay</u>	<u>63</u>	<u>90</u>
<u>Gray coarse sand</u>	<u>90</u>	<u>124</u>
<u>Gray coarse sand</u>	<u>124</u>	<u>155</u>
<u>Blue clay</u>	<u>155</u>	<u>214</u>
<u>Gray coarse sand</u>	<u>214</u>	<u>247</u>

(8) how well bottom plugged
back wash valve

DRILLERS REMARKS:

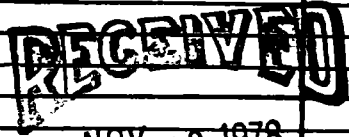

NOV - 9 1978

MISS. BD. OF WATER COMM

If well telescopes please sketch and show depths.

GROUND LEVEL

		X	

SECTION 28

Please indicate well location X.

ADDITIONAL INFORMATION

If more than one screen, show locations of each on sketch.