

JACKSON  
 Q 2053  
 5-24-79

MISSISSIPPI  
 BOARD OF WATER COMMISSIONERS  
 416 North State Street  
 Jackson, Mississippi 39201

WATER WELL DRILLERS LOG

5-24 1979 *Cross Water Well Driller* Jackson  
 date well completed firm name county well located

LANDOWNER: <i>Francis Larson</i>	description of formations encountered	from	to
P.O. Box 12, Passagoulay Miss. 39567 (mailing address)			
WELL LOCATION: sec <i>28</i> T <i>7</i> S R <i>5</i> W <i>4</i> miles <i>South E.</i> of <i>Ecaterusa</i> (distance) (direction) (nearest town)	<i>Top soil</i>	<i>0</i>	<i>2</i>
WELL PURPOSE: <i>Industrial</i> (home, irrigation, municipal, industrial)	<i>Gray Clay</i>	<i>2</i>	<i>8</i>
WELL COMPLETION DATA: (1) diameter (inches) <i>2"</i>	<i>Gray Coarse sand &amp; gravel</i>	<i>8</i>	<i>50</i>
(2) total depth (feet) <i>240'</i>	<i>Blue Clay</i>	<i>50</i>	<i>88</i>
(3) static water level (feet) <i>40'</i> below top of ground	<i>Gray Coarse sand &amp; gravel</i>	<i>88</i>	<i>130</i>
(4) casing <i>PVC</i> <i>230'</i> (material) (depth)	<i>Blue Clay</i>	<i>130</i>	<i>180</i>
<i>2"</i> (size) If telescope see back.	<i>Gray Coarse sand</i>	<i>180</i>	<i>240</i>
(5) screen <i>10'</i> <i>230'</i> (length) (depth to top)			
<i>2"</i> <i>PVC</i> (size) (material)			
(6) pump <i>1 hp.</i> <i>8</i> (HP) (yield gpm)			
<i>Chub.</i> (type power)			
(7) electric log <i>No.</i> (yes or no)			
(organization running log)			
(8) how well/bottom plugged <i>back wash valve</i>			

DEPT. OF NATURAL RESOURCES  
 BUREAU OF LAND & WATER RESOURCES


JAN 15 1980

RECEIVED

DRILLERS REMARKS:

If well telescopes please sketch and show depths.

GROUND LEVEL

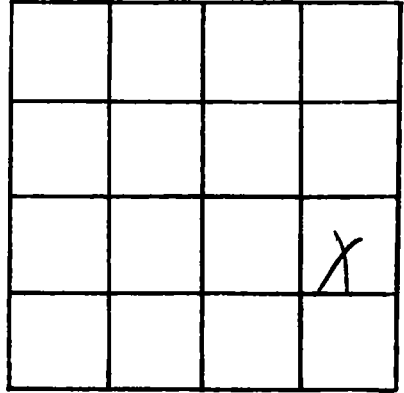

SECTION 28

Please indicate well location X.

ADDITIONAL INFORMATION

If more than one screen,  
show locations of each on sketch.