

JACKSON
 Q 2034
 5-25-79

MISSISSIPPI
 BOARD OF WATER COMMISSIONERS
 416 North State Street
 Jackson, Mississippi 39201

WATER WELL DRILLERS LOG

~~Jackson~~ 5/25/79 29 Driff Well Co Jackson
 date well completed firm name county well located

LANDOWNER:
 Carl Poole
 Moss Point Miss
 (mailing address)

WELL LOCATION:
 sec. 26 T 2 N R 5 E
 1 miles So. of Doyles Station
 (distance) (direction) (nearest town)

WELL PURPOSE:
 Home
 (home, irrigation, municipal, industrial)

- WELL COMPLETION DATA:
- (1) diameter (inches) 2 1/2
 - (2) total depth (feet) 235
 - (3) static water level (feet) 30 below top of ground
 - (4) casing PVC, 220',
 (material) (depth)
 (size) If telescope see back.
 - (5) screen 5', 220'
 (length) (depth to top)
 2" PVC
 (size) (material)
 - (6) pump 1 HP, 10 (yield gpm)
 (type power) etc
 - (7) electric log no
 (yes or no)
 (organization running log)
 - (8) how well bottom plugged BWV

description of formations encountered	from	to
gray clay	0	8'
sand	8'	10'
sand	15'	40'
C. clay + sand streaks	40'	165'
clay	165'	200'
sand	200'	235'

DRILLERS REMARKS:


Miss. Board of Water Comm.

JUN 6 1979

RECEIVED

If well telescopes please sketch and show depths.

GROUND LEVEL

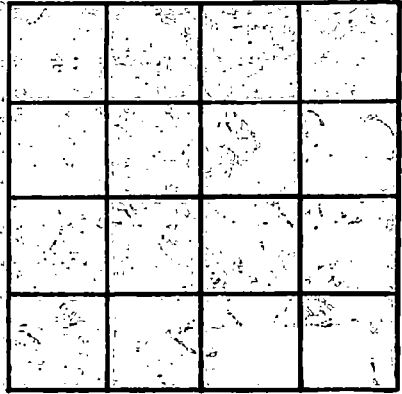

SECTION _____

Please indicate well location X.

ADDITIONAL INFORMATION

If more than one screen, show locations of each on sketch.