

JACKSON
 Q 2059
 9-24-79

MISSISSIPPI
 BOARD OF WATER COMMISSIONERS
 416 North State Street
 Jackson, Mississippi 39201

WATER WELL DRILLERS LOG

9-24-79 date well completed 1979 East Water Well Sewer Line firm name Jackson county well located

LANDOWNER: Richard M. Miley
4624 Allmond St.
Mass Point, Miss.
 (mailing address) 37563

description of formations encountered	from	to
Top soil	0	8
White Coarse sand + wood	8	64
White Coarse sand	64	108
White Coarse sand + gravel	108	148
Blue Clay	148	153
Gray med sand	153	200
gray Coarse sand	200	240

WELL LOCATION:
 sec. 15 T. 7 R. 5
2 1/4 miles East of Osceola
 (distance) (direction) (nearest town)

WELL PURPOSE: home
 (home, irrigation, municipal, industrial)

WELL COMPLETION DATA:
 (1) diameter (inches) 2"
 (2) total depth (feet) 240'
 (3) static water level (feet) 19' below above top of ground.
 (4) casing PVC 230'
 (material) (depth)
2" If telescope see back.
 (size)
 (5) screen 10' 230'
 (length) (depth to top)
2" PVC
 (size) (material)
 (6) pump 1/2 HP 8
 (HP) (yield gpm)
Elect.
 (type power)
 (7) electric log No.
 (yes or no)
 (organization running log)

(8) How well bottom plugged
Back Wash Water
 DRILLERS REMARKS:


DEPT. OF NATURAL RESOURCES
 BUREAU OF LAND & WATER RESOURCES

FEB 26 1980

RECEIVED

If well telescopes please sketch and show depths.

GROUND LEVEL

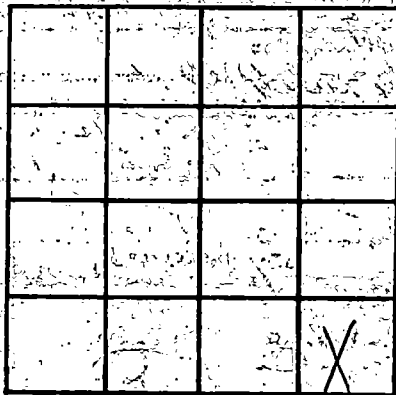

SECTION 15

Please indicate well location X.

ADDITIONAL INFORMATION

A series of 15 horizontal lines for entering additional information.

If more than one screen, show locations of each on sketch.