

JACKSON
 Q 2060
 10-2-79

MISSISSIPPI
 BOARD OF WATER COMMISSIONERS
 416 North State Street
 Jackson, Mississippi 39201

WATER WELL DRILLERS LOG

10-2-79 date well completed
 Coast Water Well Sew. Inc. firm name
 Jackson county well located

LANDOWNER: Arnold E. Mahoney
 Main P.O. Box 47,
 Orange Grove - Pass. Miss.
 Moss Point, Miss. 39553
 (mailing address)

WELL LOCATION:
 sec 22 T 7 S R 5 E
 miles 1 in East of Moss Point
 (distance) (direction) (nearest town)

WELL PURPOSE: Home
 (home, irrigation, municipal, industrial)

WELL COMPLETION DATA:
 (1) diameter (inches) 2"
 (2) total depth (feet) 215'
 (3) static water level (feet) 31' below top of ground.
 (4) casing PVC, 205' (material) (depth)
 2" (size) if telescope see back.
 (5) screen 10' length, 205' depth to top
 2" (size) PVC (material)
 (6) pump 1 1/2 hp (HP), 10 (yield gpm)
 Elec. (type power)
 (7) electric log No (yes or no)
 (organization running log)

(8) how well bottom plugged
 Back wash Valve
 DRILLERS REMARKS:

description of formations encountered	from	to
Top soil	0	1
Red Clay	1	10
White Coarse sand	10	66
Blue Clay	66	81
White Coarse sand	81	128
Blue Clay	128	180
Blue Clay & Struck Zone	180	194
Grey Coarse sand	194	215


DEPT. OF NATURAL RESOURCES
 BUREAU OF LAND & WATER RESOURCES

FEB 26 1980

RECEIVED

If well telescopes please sketch and show depths.

GROUND LEVEL

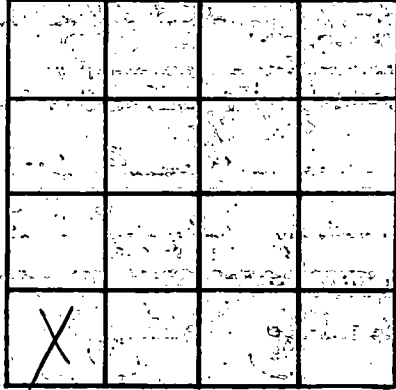

SECTION 22

Please indicate well location X.

ADDITIONAL INFORMATION

Lined area for additional information.

If more than one screen, show locations of each on sketch.