

JACKSON
 Q 206
 10-30-79

MISSISSIPPI
 BOARD OF WATER COMMISSIONERS
 416 North State Street
 Jackson, Mississippi 39201

WATER WELL DRILLERS LOG

10-30-79 date well completed
 Coast Water Well Sewer firm name
 Jackson county well located

LANDOWNER: Don Anderson
P.O. Box 8
Pascagoula, Miss.
 (mailing address) 39567

WELL LOCATION:
 sec. 23 T 7 S R 5 W
5 miles East of Escatawpa
 (distance) (direction) (nearest town)

WELL PURPOSE: Home
 (home, irrigation, municipal, industrial)

WELL COMPLETION DATA:

(1) diameter (inches) 2"

(2) total depth (feet) 236'

(3) static water level (feet) 25' ^{below} above top of ground.

(4) casing PVC 226'
 (material) (depth)

2" if telescope see back.
 (size)

(5) screen 10' 226'
 (length) (depth to top)

2" PVC
 (size) (material)

(6) pump 1 h.p. 8
 (HP) (yield gpm)

Elco
 (type power)

(7) electric log No
 (yes or no)

(organization running log)

(8) how well bottom plugged
back wash valve

DRILLERS REMARKS:

description of formations encountered	from	to
Top soil	0	8
Red Clay	8	20
White Cassin Wood + gravel	20	122
Blue Clay	122	170
gray coarse sand	170	236


DEPT. OF NATURAL RESOURCES
 BUREAU OF LAND & WATER RESOURCES

FEB 26 1980

RECEIVED

If well telescopes please sketch and show depths.

GROUND LEVEL

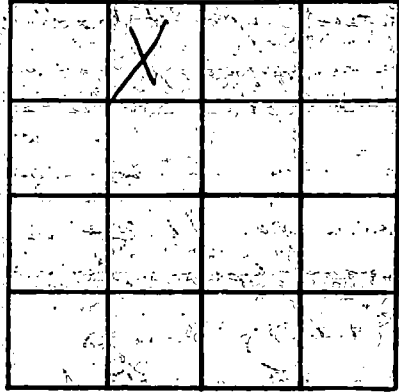

SECTION 23

Please indicate well location X.

ADDITIONAL INFORMATION

Multiple horizontal lines for additional information.

If more than one screen, show locations of each on sketch.