

Jackson  
Q 2065  
8-6-80  
Aug 6 1980

MISSISSIPPI  
 BOARD OF WATER COMMISSIONERS  
 416 North State Street  
 Jackson, Mississippi 39201

WATER WELL DRILLERS LOG

Calhoun Drilling Co Jackson  
 firm name county well located

LANDOWNER: Jerry Sanders  
Orange Grove #42  
 (mailing address)

WELL LOCATION:  
 sec. 14 T. 7 N. R. 5 E.  
4 miles NE of MP.  
 (distance) (direction) (nearest town)

WELL PURPOSE: Home  
 (home, irrigation, municipal, industrial)

WELL COMPLETION DATA:  
 (1) diameter (inches) 2"  
 (2) total depth (feet) 242  
 (3) static water level (feet) 35 below above top of ground.  
 (4) casing Galv 237  
 (material) (depth)  
 (size) If telescope see back.  
 (5) screen 5 237  
 (length) (depth to top)  
2" plastic  
 (size) (material)  
 (6) pump 1 14  
 (HP) (yield gpm)  
elec  
 (type power)  
 (7) electric log NO  
 (yes or no)  
 (organization running log)  
 (8) how well bottom plugged BP Valve

description of formations encountered	from	to
<u>medium sand</u>	<u>2</u>	<u>15</u>
<u>sand</u>	<u>15</u>	<u>22</u>
<u>sand</u>	<u>22</u>	<u>44</u>
<u>sand</u>	<u>44</u>	<u>66</u>
<u>mud</u>	<u>66</u>	<u>88</u>
<u>sand</u>	<u>88</u>	<u>110</u>
<u>sand</u>	<u>110</u>	<u>132</u>
<u>sand</u>	<u>132</u>	<u>164</u>
<u>clay sand</u>	<u>164</u>	<u>176</u>
<u>clay</u>	<u>176</u>	<u>198</u>
<u>clay</u>	<u>198</u>	<u>220</u>
<u>sand</u>	<u>220</u>	<u>242</u>

DEPT. OF NATURAL RESOURCES  
 BUREAU OF LAND & WATER RESOURCES


JUN 5 1981

RECEIVED

DRILLERS REMARKS:

If well telescopes please sketch and show depths.

GROUND LEVEL

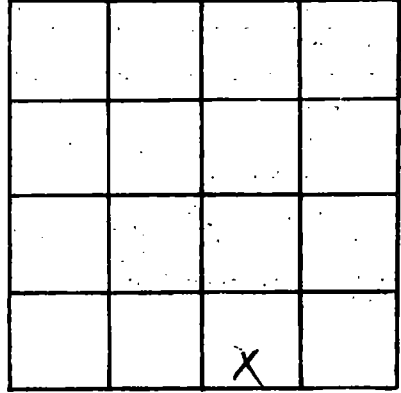

SECTION 14

Please indicate well location X.

ADDITIONAL INFORMATION

If more than one screen, show locations of each on sketch.