

JACKSON
 Q 7066
 9/29/80
 9-29

MISSISSIPPI
 BOARD OF WATER COMMISSIONERS
 416 North State Street
 Jackson, Mississippi 39201

WATER WELL DRILLERS LOG

date well completed: 9-29-80
 firm name: 50 Coast Water Well Service, Jackson
 county well located: Jackson

LANDOWNER: A. Kenneth Ramsey
 3005 Old Military Hwy
 Pascagoula, Miss
 (mailing address) 39567

| description of formations encountered | from | to |
|---------------------------------------|------|------|
| Top soil | 0 | 5 |
| blue clay & sand | 5' | 40' |
| Red coarse sand | 40' | 60' |
| blue clay | 60' | 155' |
| White coarse sand & gravel | 155' | 193' |

WELL LOCATION:
 sec. 18 T. 8 S. R. 5 E
 IN miles of Pascagoula
 (distance) (direction) (nearest town)

WELL PURPOSE: Home
 (home, irrigation, municipal, industrial)

WELL COMPLETION DATA:
 (1) diameter (inches) 2"
 (2) total depth (feet) 193'
 (3) static water level (feet) 24' below top of ground.
 (4) casing PVC, 183' (material) (depth)
 2" (size) If telescope see back.
 (5) screen 10' length, 183' depth to top
 2" PVC (size) (material)
 (6) pump 1 HP, 10 (HP) (yield gpm)
 Elec. (type power)
 (7) electric log No. (yes or no)
 N/A (organization running log)

(8) how well bottom plugged
 backwash valve

DRILLERS REMARKS:


DEPT. OF NATURAL RESOURCES
 BUREAU OF LAND & WATER RESOURCES

APR - 6 1981

RECEIVED

If well telescopes please sketch and show depths.

GROUND LEVEL

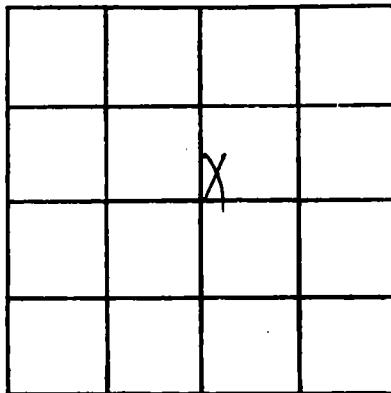

SECTION 18

Please indicate well location X.

ADDITIONAL INFORMATION

Lined area for additional information.

If more than one screen, show locations of each on sketch.