

Jackson
 Q 2067
 3-6-81

MISSISSIPPI
 BOARD OF WATER COMMISSIONERS
 416 North State Street
 Jackson, Mississippi 39201

WATER WELL DRILLERS LOG

March 6 1981 Cobble Drilling Co. Jackson
 date well completed firm name county well located

LANDOWNER: J. O. Maple
 Orange Grove
 (mailing address)

WELL LOCATION:
 23 sec 7 T 7 N R 5 E
 5 miles out of MP
 (distance) (direction) (nearest town)

WELL PURPOSE: Home
 (home, irrigation, municipal, industrial)

WELL COMPLETION DATA:
 (1) diameter (inches) 2
 (2) total depth (feet) 259
 (3) static water level (feet) 35 below top of ground
 (4) casing plastic 259 (material) (depth)
 (size) if telescope see back.
 (5) screen 5 259 (length) (depth to top)
 2" plastic (size) (material)
 (6) pump 1 15 (HP) (yield gpm)
 elec (type power)
 (7) electric log no (yes or no)
 (organization running log)
 (8) how well bottom plugged B.P. clay

description of formations encountered	from	to
red clay	0	15
sand	15	22
sand	22	44
sand	44	66
sand	66	88
gale's sand	88	110
sand	110	132
clay sand	132	154
clay	154	170
sand	170	198
sand	198	220
sand	220	244

DEPT. OF NATURAL RESOURCES
 BUREAU OF LAND & WATER RESOURCES

JUN 5 - 1981


RECEIVED

DRILLERS REMARKS:

23

If well telescopes please sketch and show depths.

GROUND LEVEL

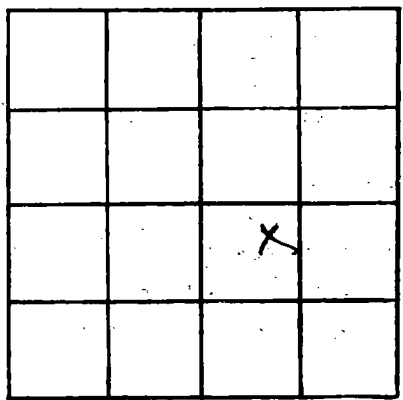

SECTION ~~20~~

Please indicate well location X. 23

ADDITIONAL INFORMATION

Lined area for additional information.

If more than one screen, show locations of each on sketch.