

JACKSON  
 Q 2072  
 2/10/81  
 Feb. 10 1981

MISSISSIPPI  
 BOARD OF WATER COMMISSIONERS  
 416 North State Street  
 Jackson, Mississippi 39201

WATER WELL DRILLERS LOG

date well completed 1981 firm name Charles Dilling Co. county well located Jackson

LANDOWNER: Akleyton  
Dupon  
Bayou Cambost. 4th  
 (mailing address)

WELL LOCATION:

sec. 27 7 N R. 5 E  
4 miles east of W.P.  
 (distance) (direction) (nearest town)

WELL PURPOSE:

(home, irrigation, municipal, industrial) Home

WELL COMPLETION DATA:

- (1) diameter (inches) 2"
- (2) total depth (feet) 264
- (3) static water level (feet) 35 <sup>below</sup> <sub>above</sub> top of ground.
- (4) casing plastic, 259  
 (material) (depth)  
 (size) if telescope see back.
- (5) screen 5' 259  
 (length) (depth to top)  
2" plastic  
 (size) (material)
- (6) pump 1 1/2 20  
 (HP) (yield gpm)  
dec  
 (type power)
- (7) electric log no  
 (yes or no)  
 (organization running log)
- (8) how well bottom plugged B.P. Weber

description of formations encountered

from to

sandy clay	0	10
sand	10	22
sand	22	44
sand	44	66
sand	66	88
sand	88	110
sand	110	132
sand	132	154
sand	154	176
sand	176	180
clay	180	198
clay	198	210
sand	210	222
sand	222	242
sand	242	264

DEPT. OF NATURAL RESOURCES  
 BUREAU OF LAND & WATER RESOURCES


JUN 5 - 1981

RECEIVED

DRILLERS REMARKS:

If well telescopes please sketch and show depths.

GROUND LEVEL

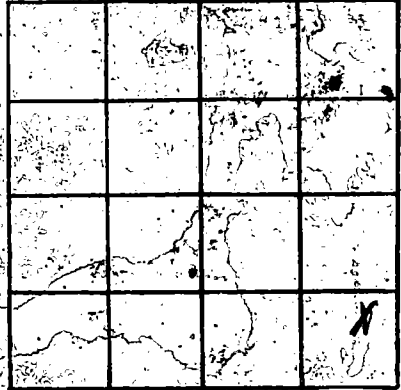

SECTION 27

Please indicate well location X.

ADDITIONAL INFORMATION

If more than one screen, show locations of each on sketch.