

MISSISSIPPI DEPARTMENT OF NATURAL RESOURCES

Bureau of Land and Water Resources

Southport Mall

P.O. Box 10631

Jackson, Mississippi 39209

WATER WELL DRILLERS LOG

Jackson  
Q 2073  
4-8-81

4-8-81 date well completed  
19 Coast Water Well Sewer. Jackson firm name  
Jackson county well located

LANDOWNER: Raymond P. Hill

description of formations encountered from to

Box 876  
Pascagoula Miss.  
(mailing address)

Top soil 0 2'

WELL LOCATION:

Gray Clay 2' 10'

sec. 13 T 7 S R 5 E  
4 miles E of Mass Point  
(distance) (direction) (nearest town)

C Sand - Gravel 10' 165'

WELL PURPOSE: None  
(home, irrigation, municipal, industrial)

Blue Clay 115' 180'

WELL COMPLETION DATA:

C Sand 180' 200'

- (1) diameter (inches) 2"
- (2) total depth (feet) 249'
- (3) static water level (feet) 15' below top of ground.
- (4) casing PVC 239' (material) (depth)
- 2" (size) if telescope see back.
- (5) screen 10' 239' (length) (depth to top)
- 24" PVC (size) (material)
- (6) pump 1 hp. 12 (HP) (yield gpm)
- elect. (type power)
- (7) electric log No. (yes or no)

B. Clay 200' 225'

M.C. Sand 225' 249'

(organization running log)

(8) How well bottom plugged? Backwash Valve

DRILLERS REMARKS:


DEPT. OF NATURAL RESOURCES  
BUREAU OF LAND & WATER RESOURCES

JUN 2 - 1981

RECEIVED

If well telescopes please sketch and show depths.

GROUND LEVEL

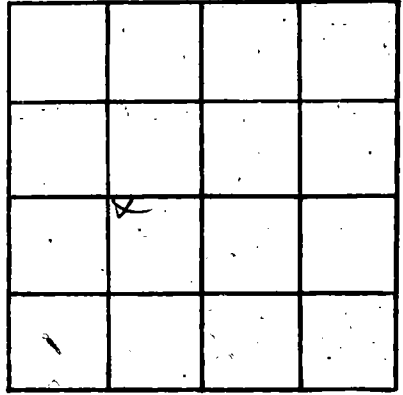

SECTION B

Please indicate well location X.

ADDITIONAL INFORMATION

A series of 18 horizontal lines for entering additional information.

If more than one screen, show locations of each on sketch.