

JACKSON
 Q 2074
 4-20-81

MISSISSIPPI
 BOARD OF WATER COMMISSIONERS
 416 North State Street
 Jackson, Mississippi 39201

WATER WELL DRILLERS LOG

April 20 1981 Colville Drilling Co. Jackson
 date well completed firm name county well located

LANDOWNER: Clifton
 Buck
 Orange Grove, MS
 (mailing address)

description of formations encountered	from	to
Clay	0	15
sand	15	22
sand	22	44
sand	44	66
sand	66	88
sand	88	110
sand	110	132
sand	132	154
sand	154	160
Clay	160	176
Clay	176	180
sand	180	192
sand	192	220
sand	220	242

WELL LOCATION:
 sec. 23 T 7 N R 5 E
 4 1/2 miles east of WPD
 (distance) (direction) (nearest town)

WELL PURPOSE: Home
 (home, irrigation, municipal, industrial)

- WELL COMPLETION DATA:
- diameter (inches) 2
 - total depth (feet) 242
 - static water level (feet) 35 below top of ground
 - casing plastic 237 (material) (depth)
 (size) if telescope see back.
 - screen 5' 237 (length) (depth to top)
 2" plastic (size) (material)
 - pump 1 17 (HP) (yield gpm)
 id.e (type power)
 - electric log no (yes or no)
 (organization running log)
 - how well bottom plugged BP Valve

DEPT. OF NATURAL RESOURCES
 BUREAU OF LAND & WATER RESOURCES


JUN 5 - 1981

RECEIVED

DRILLERS REMARKS:

If well telescopes please sketch and show depths.

GROUND LEVEL

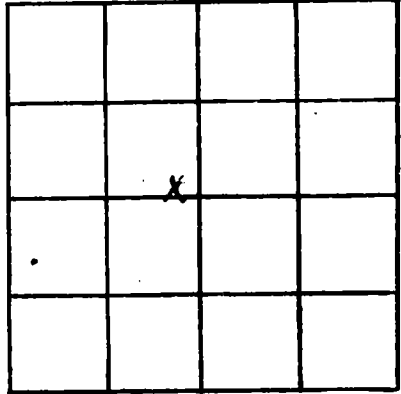

SECTION 23

Please indicate well location X.

ADDITIONAL INFORMATION

If more than one screen,
show locations of each on sketch.