

Jac Kson  
Q 7076  
5-15-81

MISSISSIPPI  
BOARD OF WATER COMMISSIONERS  
416 North State Street  
Jackson, Mississippi 39201

WATER WELL DRILLERS LOG

May 15 1981 date well completed  
Cobell Drilling Co firm name  
Jackson county well located

LANDOWNER: Summers  
Bayou Lambert Ms.  
(mailing address)

description of formations encountered	from	to
Clay	0	15
sand	15	22
sand	22	24
sand	24	44
sand	44	66
sand	66	88
sand	88	110
sand	110	132
sand	132	154
sand	154	176
sand	176	180
Clay	180	198
Clay	198	210
sand	210	220
sand	220	242
sand	242	263

WELL LOCATION:  
sec. 26 T 7 N R 5 E  
4 miles East of MF.  
(distance) (direction) (nearest town)

WELL PURPOSE: Home  
(home, irrigation, municipal, industrial)


WELL COMPLETION DATA:  
(1) diameter (inches) 2"  
(2) total depth (feet) 263  
(3) static water level (feet) 35 below top of ground  
(4) casing plastic, 258,  
(material) (depth)  
(size) If telescope see back.  
(5) screen 5, 258  
(length) (depth to top)  
2", plastic  
(size) (material)  
(6) pump 1, 15  
(HP) (yield gpm)  
elc  
(type power)  
(7) electric log no  
(yes or no)  
(organization running log)  
(8) how well bottom plugged DP label

*Please send form*  
*DP label*  
DEPT. OF NATURAL RESOURCES  
BUREAU OF LAND & WATER RESOURCES  
JUN 5-1981  
RECEIVED

DRILLERS REMARKS:

If well telescopes please sketch and show depths.

GROUND LEVEL

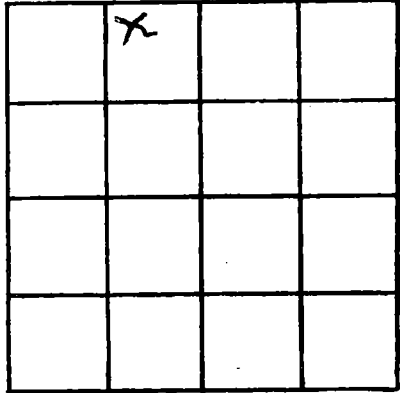

SECTION 26

Please indicate well location X.

ADDITIONAL INFORMATION

If more than one screen, show locations of each on sketch.