

MISSISSIPPI DEPARTMENT OF NATURAL RESOURCES

Bureau of Land and Water Resources

Southport Mall

P.O. Box 10631

Jackson, Mississippi 39209

WATER WELL DRILLERS LOG

Jackson
Q 2077
6-17-81

6-17-81 19 Cross Water Well Sew. Jackson
date well completed firm name county well located

LANDOWNER: Walter Peabody
Box 1 - Box 904
Pascagoula, Miss.
(mailing address) 39367

Description of formations encountered	from	to
Red Clay	0	10'
Coarse sand - G.	10'	100'
Clay C. Sand G.	100'	165'
C. Sand	165'	240'

WELL LOCATION:
sec. 14 T. 6 S. R. 5 E
2 1/2 miles (distance) of (direction) of (nearest town) ~~POINT~~

WELL PURPOSE: Home
(home, irrigation, municipal, industrial)

WELL COMPLETION DATA:

- (1) diameter (inches) 2"
- (2) total depth (feet) 240'
- (3) static water level (feet) 30' below top of ground
- (4) casing PVC, 230' (material) (depth)
- (5) screen 10' (length), 230' (depth to top)
- (6) pump 2" (size) PVC (material), 1/2 (HP), 7 (yield gpm)
- (7) electric log No- (yes or no)

(organization running log)


(8) how well bottom plugged Back Wash Valve

DRILLERS REMARKS:



If well telescopes please sketch and show depths.

GROUND LEVEL

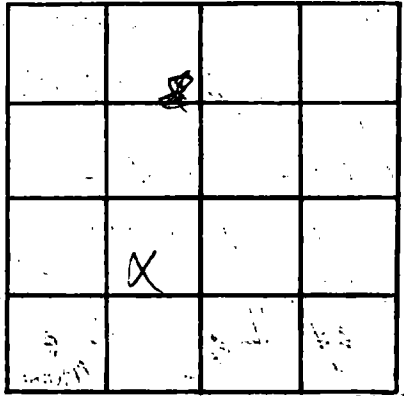

SECTION 14

Please indicate well location X.

ADDITIONAL INFORMATION

If more than one screen, show locations of each on sketch.